

Monroe  
 O 2021  
 8-68

MISSISSIPPI  
 BOARD OF WATER COMMISSIONERS  
 416 North State Street  
 Jackson, Mississippi 39201

WATER WELL DRILLERS LOG

Thomas Well & Supply, Inc.  
 P. O. Box 42  
 MONROE, MISSISSIPPI  
 county well located

8-8 19 68  
 date well completed

firm name

LANDOWNER:

Freddy Miller  
 Rt 1 Prairie, Miss  
 (mailing address)

description of formations encountered

	from	to
Surface clay	0	18
Blue clay	18	280
Sand	280	400
Boths	400	

WELL LOCATION:

sec. 4 T. 16 N R. 6 E  
 S W  
 1/2 miles SW of Marlow  
 (distance) (direction) (nearest town)


WELL PURPOSE:

Home  
 (home, irrigation, municipal, industrial)

WELL COMPLETION DATA:

- (1) diameter (inches) 5"
- (2) total depth (feet) 400'
- (3) static water level (feet) 120' below top of ground.
- (4) casing steel 20' 3" (material) (depth)
- NO (size) if telescope see back.
- (5) screen NO (length) (depth to top)
- (size) (material)
- (6) pump Bg 27 (HP) (yield gpm)
- (type power)
- (7) electric log NO (yes or no)
- (organization running log)
- (8) how well bottom plugged spec

DRILLERS REMARKS:

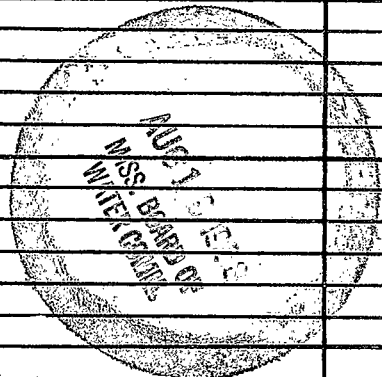

If well telescopes please sketch and show depths.

GROUND LEVEL


SECTION 4

Please indicate well location X.

ADDITIONAL INFORMATION

If more than one screen,  
show locations of each on sketch.