

Monroe
 2022
 9-8-75

MISSISSIPPI
 BOARD OF WATER COMMISSIONERS
 416 North State Street
 Jackson, Mississippi 39201

WATER WELL DRILLERS LOG

Herman Homan Well & Supply, Inc.
 P. O. Box 42
 firm name

SHANNON, MISSISSIPPI 38868

7/18 19 25
 date/well completed

Monroe
 county well located


LANDOWNER:	description of formations encountered	from	to
Charles Edwards Farmer, Jr. Box 702, A Bourbon Miss (mailing address)	Surface sand & clay Blue clay Sand Bottom	0 18 220 360	18 220 360
WELL LOCATION: sec. <u>8</u> T. <u>15</u> N. R. <u>6</u> E. <u>1 1/2</u> miles <u>SW</u> of <u>PRVILLE</u> (distance) (direction) (nearest town)			
WELL PURPOSE: <u>FAVOR</u> (home, irrigation, municipal, industrial)			
WELL COMPLETION DATA:			
(1) diameter (inches) <u>4"</u>			
(2) total depth (feet) <u>360'</u>			
(3) static water level (feet) <u>130'</u> below top of ground.			
(4) casing <u>Steel</u> , <u>21'</u> (material) (depth) <u>4"</u> (size) If telescope see back.			
(5) screen <u>NO</u> , (length) (depth to top) (size) (material)			
(6) pump <u>3/4</u> <u>7</u> (HP) (yield gpm) <u>Chlor</u> (type power)			
(7) electric log <u>NO</u> (yes or no)			
(organization running log)			
(8) how well bottom plugged <u>open</u>			
DRILLERS REMARKS:			

MISSISSIPPI BOARD OF WATER COMMISSIONERS
 OCT 20 1975

MISS. Bd. OF WATER COMMISSIONERS

If well telescopes please sketch and show depths.

GROUND LEVEL

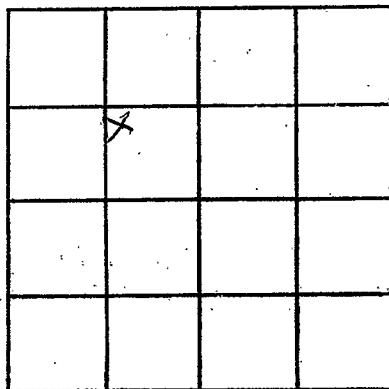

SECTION 8

Please indicate well location X.

ADDITIONAL INFORMATION

If more than one screen,
show locations of each on sketch.