

Monroe
φ 2024
11-29-75

MISSISSIPPI
 BOARD OF WATER COMMISSIONERS
 416 North State Street
 13 L Jackson, Mississippi 39201

WATER WELL DRILLERS LOG

Herman Homan Well & Supply, Inc.
 P. O. Box 42

Monroe

11/29 1975
 date well completed

SHANNON, MISSISSIPPI 38868
 firm name

county well located

LANDOWNER:
George Watson
at 4 Aberdeen, Miss
 (mailing address)

description of formations encountered	from	to
<u>surface clay</u>	<u>0</u>	<u>30</u>
<u>blue clay</u>	<u>30</u>	<u>280</u>
<u>sand</u>	<u>280</u>	<u>320</u>
<u>Barton</u>	<u>320</u>	

WELL LOCATION:
 sec. 13 T. 16 N. R. 6 E.
S W
1 miles SW of Strong
 (distance) (direction) (nearest town)

WELL PURPOSE: farm
 (home, irrigation, municipal, industrial)

WELL COMPLETION DATA:

(1) diameter (inches) 4"

(2) total depth (feet) 320'

(3) static water level (feet) 136' below top of ground.

(4) casing steel, 39'5"
 (material) (depth)
4" if telescope see back.
 (size)

(5) screen no
 (length) (depth to top)
 (size) (material)

(6) pump 3hp 7
 (HP) (yield gpm)
elect
 (type power)

(7) electric log no
 (yes or no)

(organization running log)


(8) how well bottom plugged open

DRILLERS REMARKS:

MISSISSIPPI BOARD OF WATER COMMISSIONERS
 JAN 6 1976
 MISS. BD. OF WATER COMMISSIONERS

If well telescopes please sketch and show depths.

GROUND LEVEL

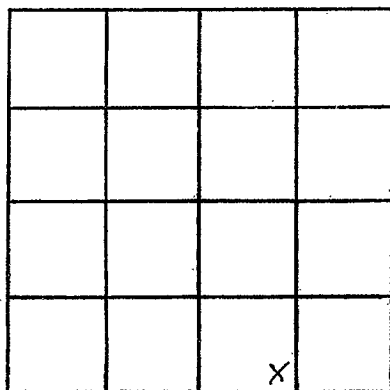

SECTION 13

Please indicate well location X.

ADDITIONAL INFORMATION

If more than one screen, show locations of each on sketch.