

MONROE
 2025
 2-16-76

MISSISSIPPI
 BOARD OF WATER COMMISSIONERS
 416 North State Street
 Jackson, Mississippi 39201

WATER WELL DRILLERS LOG

Herman Herman Well & Supply, Inc.

P. O. Box 42

SHANNON, MISSISSIPPI 38868


Monroe
 county well located

2-16 1976
 date well completed

| LANDOWNER: | description of formations encountered | from | to |
|--|---|------------------|----|
| Justiss & Meaus | Sandy gravel | | |
| PO BOX 11, JENA LA. (mailing address) | Clay Blue clay | 2 1/8 18 2 00 | |
| WELL LOCATION: sec. 27 T 15 N R 6 E S # # 1 miles NE of Malden (distance) (direction) (nearest town) | Sand Silt | 2 40 3 40 | |
| WELL PURPOSE: oil well drilled (home, irrigation, municipal, industrial) | | | |
| WELL COMPLETION DATA: (1) diameter (inches) 4 9 (2) total depth (feet) 380 (3) static water level (feet) 120 below above top of ground. (4) casing Steel 26' (material) (depth) 4 1/2" (size) if telescope see back. (5) screen NO (length) (depth to top) (size) (material) (6) pump NO (HP) (yield gpm) (type power) (7) electric log NO (yes or no) (organization running log) (8) how well bottom plugged open | | | |
| DRILLERS REMARKS: | MAR 10 1976 MISS. Bd. OF WATER COMM. | | |

If well telescopes please sketch and show depths.

GROUND LEVEL

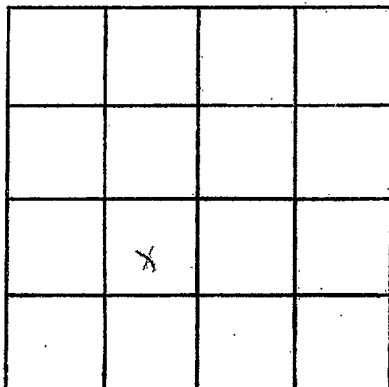

SECTION 27

Please indicate well location X.

ADDITIONAL INFORMATION

If more than one screen, show locations of each on sketch.