

MONROE
 O 2026
 3/29/76

MISSISSIPPI
 BOARD OF WATER COMMISSIONERS
 416 North State Street
 Jackson, Mississippi 39201

WATER WELL DRILLERS LOG

Herman Homan Well & Supply, Inc.
 P. O. Box 42
 SHANNON, MISSISSIPPI 38868

13E

1976

3/4/76
 date well completed

Monroe
 county well located

LANDOWNER:
 Justice & Means
 SENA, La.
 (mailing address)

description of formations encountered	from	to
surface clay	0	28
blue clay	28	240
sand	240	380
Bottom	380	

WELL LOCATION:
 sec. 27 T 15 N R 6 E
 1 miles S of Mulden
 (distance) (direction) (nearest town)

WELL PURPOSE: gas well
 (home, irrigation, municipal, industrial)


- WELL COMPLETION DATA:**
- (1) diameter (inches) 4"
 - (2) total depth (feet) 380'
 - (3) static water level (feet) 120 below top of ground
 - (4) casing steel 34' (material) (depth)
4" (size) if telescope see back.
 - (5) screen RD (length) (depth to top)
 (size) (material)
 - (6) pump NO (HP) (yield gpm)
 (type power)
 - (7) electric log RD (yes or no)
 (organization running log)
 - (8) how well bottom plugged spec

DRILLERS REMARKS:

RECEIVED
 MISSISSIPPI BOARD OF WATER COMMISSIONERS
 APR 27 1976
 MISS. Bd. OF WATER COMMISSIONERS

If well telescopes please sketch and show depths.

GROUND LEVEL

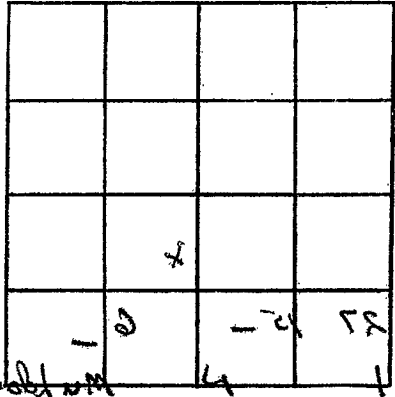

SECTION _____

Please indicate well location X.

ADDITIONAL INFORMATION

If more than one screen, show locations of each on sketch.