

MONROE
 2027
 4-7-76

MISSISSIPPI
 BOARD OF WATER COMMISSIONERS
 416 North State Street
 Jackson, Mississippi 39201

WATER WELL DRILLERS LOG

134
 4/7 1976 Herman Homan Well & Supply, Inc.
 P. O. Box 12
 Hannan, Mississippi 38868
 MONROE county well located

LANDOWNER:
 Fast's Farms
 Leona, LA
 (mailing address)

description of formations encountered	from	to
Surface clay	0	16
Blue clay	16	260
Sand	260	420
Bottom	420	

WELL LOCATION:
 sec 27 T 15 N R 6 E
 S W
 1 miles W of Mulden
 (distance) (direction) (nearest town)

WELL PURPOSE: GAS W.D.I.
 (home, irrigation, municipal, industrial)

WELL COMPLETION DATA:

(1) diameter (inches) 8 1/2

(2) total depth (feet) 420

(3) static water level (feet) 115 below top of ground

(4) casing (material) (depth) 21'

8 1/2 (size) If telescope see back.

(5) screen (length) (depth to top)

(size) (material)

(6) pump (HP) (yield gpm)

(type power)

(7) electric log (yes or no) W.D.

(organization running log)


(8) how well bottom plugged open

DRILLERS REMARKS:

APR 27 1976
 MISS. RD. OF WATER COMM.

If well telescopes please sketch and show depths.

GROUND LEVEL

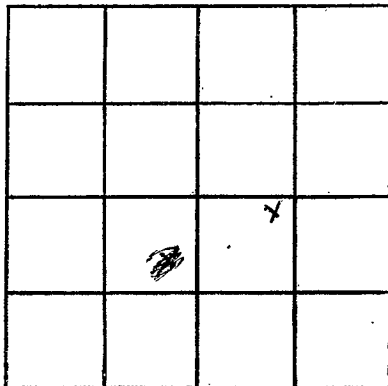

SECTION 27

Please indicate well location X.

ADDITIONAL INFORMATION

If more than one screen, show locations of each on sketch.