

MONROE
 # 2028
 5-12-76

MISSISSIPPI
 BOARD OF WATER COMMISSIONERS
 416 North State Street
 Jackson, Mississippi 39201

WATER WELL DRILLERS LOG

512 19 76 Herman Homan Well & Supply, Inc. Monroe
 date well completed firm name county well located
 MISSISSIPPI 38168

LANDOWNER:
Fustess & Meers
Jena, La
 (mailing address)

description of formations encountered	from	to
<u>Surface clay</u>	<u>0</u>	<u>16</u>
<u>blue clay</u>	<u>16</u>	<u>120</u>
<u>sand</u>	<u>220</u>	<u>360</u>
<u>clay</u>	<u>360</u>	<u>380</u>
<u>sand</u>	<u>380</u>	<u>420</u>
<u>clay</u>	<u>420</u>	<u>420</u>

WELL LOCATION:
 sec 27 T 15 N R 6 E
 S W
1 miles N of Monroe
 (distance) (direction) (nearest town)

WELL PURPOSE: 525 well water
 (home, irrigation, municipal, industrial)


- WELL COMPLETION DATA:
- (1) diameter (inches) 4"
 - (2) total depth (feet) 410
 - (3) static water level (feet) 115 below top of ground.
 - (4) casing steel, 20' (material) (depth)
4" if telescope see back.
 (size)
 - (5) screen ND (length) (depth to top)
 (size) (material)
 - (6) pump ND (HP) (yield gpm)
 (type power)
 - (7) electric log ND (yes or no)
 (organization running log)
 - (8) how well bottom plugged open

DRILLERS REMARKS:

RECEIVED
 JUN 8 1976
 MISS. Bd. of Water Comm.

If well telescopes please
sketch and show depths.

GROUND LEVEL

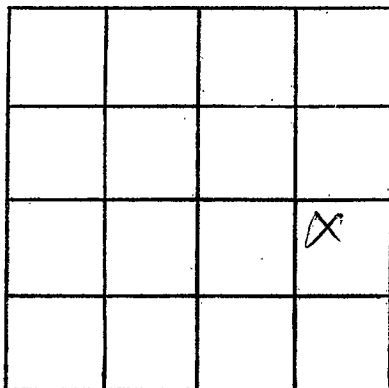

SECTION 27

Please indicate well location X.

ADDITIONAL INFORMATION

If more than one screen,
show locations of each on sketch.