

Monroe
 2029
 15-22-76

MISSISSIPPI
 BOARD OF WATER COMMISSIONERS
 416 North State Street
 Jackson, Mississippi 39201

WATER WELL DRILLERS LOG

8/22 1976
 date well completed

Herman Homan Well & Supply, Inc.

Monroe
 county well located


P. O. Box 42
 SHANNON, MISSISSIPPI 38868

LANDOWNER:	description of formations encountered	from	to
Charles Edwards Farms Abundson, Ms. (mailing address)	surface sand & clay Baker clay Sand Baker	0	16 220 220 420
WELL LOCATION: sec. 9 T. 15 N. R. 6 E 1 1/2 miles W of Prairie (distance) (direction) (nearest town)			
WELL PURPOSE: Home, irrigation, municipal, industrial			
WELL COMPLETION DATA: (1) diameter (inches) 5 1/4 (2) total depth (feet) 420' (3) static water level (feet) 130' below top of ground. (4) casing (material) 20' 6" (depth) 5 1/4 (size) If telescope see back. (5) screen (length) (depth to top) (size) (material) (6) pump (HP) (yield gpm) electric (type power) (7) electric log (yes or no) (organization running log) (8) how well bottom plugged open			
DRILLERS REMARKS:			

JUL 11 1976
 MISS. BOARD OF WATER COMMISSIONERS

If well telescopes please sketch and show depths.

GROUND LEVEL

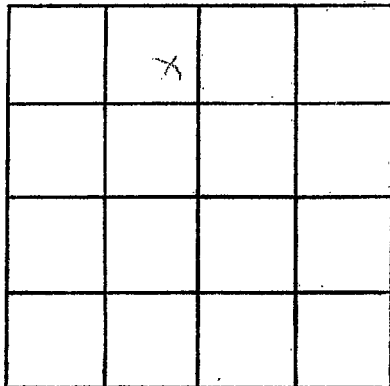

SECTION 8

Please indicate well location X.

ADDITIONAL INFORMATION

If more than one screen, show locations of each on sketch.