

Monroe  
 # 2030  
 6-22-76

MISSISSIPPI  
 BOARD OF WATER COMMISSIONERS  
 416 North State Street  
 Jackson, Mississippi 39201

WATER WELL DRILLERS LOG

6/22 1976 date well completed  
 Herman Homan Well & Supply, Inc. P.O. Box 42  
 SHANNON, MISSISSIPPI 38868  
 MONROE county well located

LANDOWNER:  
 Justice & Aunts  
 Tenn. Co.  
 (mailing address)

description of formations encountered	from	to
Surface clay	0	16
Blue clay	16	260
Sand	262	420
Bottom	420	

WELL LOCATION:  
 sec. 28 T. 15 N. R. 6 E. S. W.  
 1 1/2 miles N.W. of Muldon  
 (distance) (direction) (nearest town)

WELL PURPOSE: cons. well prod.  
 (home, irrigation, municipal, industrial)

- WELL COMPLETION DATA:
- (1) diameter (inches) 4 1/2
  - (2) total depth (feet) 420
  - (3) static water level (feet) 215 below top of ground.
  - (4) casing steel, 2 1/2 (material) (depth)  
4 1/2 (size) if telescope see back.
  - (5) screen 10 (length) (depth to top)  
 (size) (material)
  - (6) pump 1/2 (HP) (yield gpm)  
 (type power)
  - (7) electric log no (yes or no)  
 (organization running log)
  - (8) how well bottom plugged yes


RECEIVED  
 JUL 29 1976

DRILLERS REMARKS:

MISS. BD. OF WATER COMMISSIONERS

If well telescopes please sketch and show depths.

GROUND LEVEL

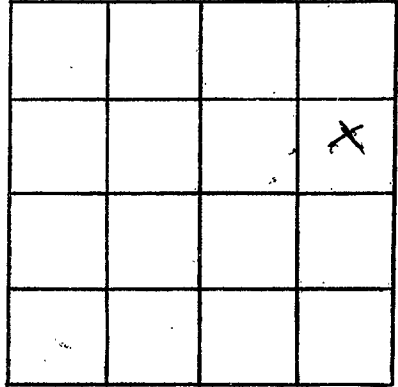

SECTION 28

Please indicate well location X.

ADDITIONAL INFORMATION

If more than one screen,  
show locations of each on sketch.