

Monroe
 # 232
 7-28-76

MISSISSIPPI
 BOARD OF WATER COMMISSIONERS
 416 North State Street
 Jackson, Mississippi 39201

WATER WELL DRILLERS LOG

Herman Homan Well & Supply, Inc.

P. O. Box 42

SHANNON, MISSISSIPPI 38868

Monroe
 county well located

7-28
 date well completed

1976

LANDOWNER:
 Justiss & Meads
 Jena LA.
 (mailing address)

description of formations encountered	from	to
Surface clay	0	16
Blue clay	16	240
Sand	240	230
Bottom	230	

WELL LOCATION:
 sec. 27 T. 15 N. R. 6 E.
 1/4 miles N of Mulden
 (distance) (direction) (nearest town)

WELL PURPOSE: gas well
 (home, irrigation, municipal, industrial)

WELL COMPLETION DATA:

(1) diameter (inches) 4"

(2) total depth (feet) 230'

(3) static water level (feet) 120' below top of ground.

(4) casing (material) steel, (depth) 44'

4" If telescope see back.
 (size)

(5) screen (length) (depth to top)

(size) (material)

(6) pump (HP) (yield gpm)

(type power)

(7) electric log (yes or no)

(organization running log)

(8) how well bottom plugged open


DRILLERS REMARKS:

RECEIVED
 AUG 16 1976

MISS. BD. OF WATER COMMISSIONERS

If well telescopes please sketch and show depths.

GROUND LEVEL

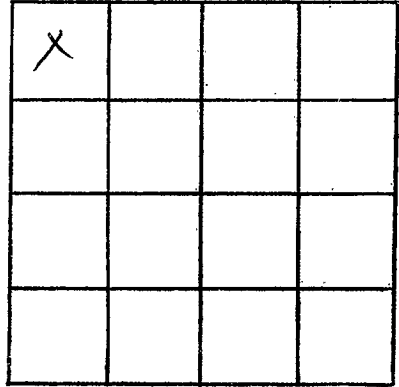

SECTION 27

Please indicate well location X.

ADDITIONAL INFORMATION

If more than one screen, show locations of each on sketch.