

MONROE
 2033
 8-19-76

MISSISSIPPI
 BOARD OF WATER COMMISSIONERS
 416 North State Street
 Jackson, Mississippi 39201

WATER WELL DRILLERS LOG

8/19 1976 date well completed
 Herman Homan Well & Supply, Inc. firm name
 SHANNON MISSISSIPPI 38869
 MONROE county well located

LANDOWNER:
 JUSTICE FAUCUS
 JENA LA.
 (mailing address)

description of formations encountered	from	to
Surface clay	0	18
Blue clay	18	260
Sand	260	380
Blue clay	380	525
Sand	525	410
Bed	410	

WELL LOCATION:
 sec. 28 T. 15 N. R. 6 E
 1 miles N.W. of Muldo
 (distance) (direction) (nearest town)

WELL PURPOSE: GAS WELL
 (home, irrigation, municipal, industrial)

- WELL COMPLETION DATA:
- (1) diameter (inches) 4 1/4
 - (2) total depth (feet) 420
 - (3) static water level (feet) 115 below above top of ground.
 - (4) casing Steel 21
 (material) (depth)
9 If telescope see back.
 (size)
 - (5) screen ND
 (length) (depth to top)
 (size) (material)
 - (6) pump ND
 (HP) (yield gpm)
 (type power)
 - (7) electric log ND
 (yes or no)
 (organization running log)
 - (8) how well bottom plugged open


DRILLERS REMARKS:
 #9

RECEIVED
 SEP 20 1976

MISS. BD. OF WATER COMMISSIONERS

If well telescopes please sketch and show depths.

GROUND LEVEL

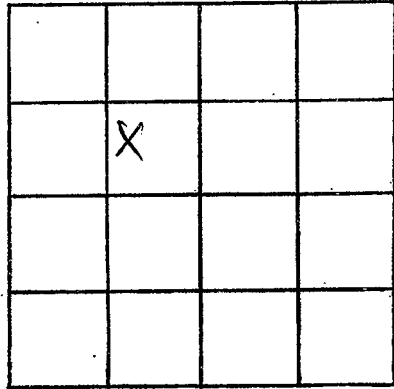

SECTION 28

Please indicate well location X.

ADDITIONAL INFORMATION

If more than one screen, show locations of each on sketch.