

Monroe
 2034
 8/23/76

MISSISSIPPI
 BOARD OF WATER COMMISSIONERS
 416 North State Street
 Jackson, Mississippi 39201

WATER WELL DRILLERS LOG

8/23 1976 Herman Homan Well & Supply, Inc.
 date well completed PI 6, Bore #2
 county well located Monroe

SHANNON, MISSISSIPPI 38868

LANDOWNER: Justiss & Morris
 description of formations encountered: surface clay 0-17, blue clay 17-260, sand 260-380, blue clay 380-395, sand 395-420, bottom 420
 from to

WELL LOCATION:
 sec 28 T 15 N R 6 E
 S W
 1 miles NW of Muldoon
 (distance) (direction) (nearest town)

WELL PURPOSE: GAS WELLS
 (home, irrigation, municipal, industrial)

WELL COMPLETION DATA:
 (1) diameter (inches) 4 1/2
 (2) total depth (feet) 420
 (3) static water level (feet) 105 below top of ground.
 (4) casing steel 28 (material), (depth)
 4 1/2 (size) If telescope see back.
 (5) screen 20 (length), (depth to top)
 (size) (material)
 (6) pump 1/2 (HP), (yield gpm)
 (type power)
 (7) electric log NO (yes or no)
 (organization running log)
 (8) how well bottom plugged open


DRILLERS REMARKS:
 #14

RECEIVED

SEP 20 1976

If well telescopes please sketch and show depths.

GROUND LEVEL

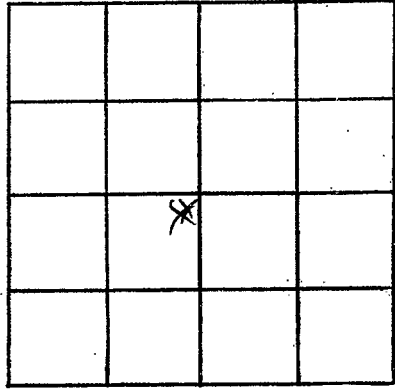

SECTION 28

Please indicate well location X.

ADDITIONAL INFORMATION

If more than one screen, show locations of each on sketch.