

MONROE  
 2035  
 8/25/76

MISSISSIPPI  
 BOARD OF WATER COMMISSIONERS  
 416 North State Street  
 Jackson, Mississippi 39201

WATER WELL DRILLERS LOG

8/25 1976  
 date well completed  
 Herman Homan Well & Supply, Inc.  
 P. O. Box 42  
 SHANNON, MISSISSIPPI 38868  
 county well located

LANDOWNER:

Justice Means

JONA LAY  
 (mailing address)

description of formations encountered

from to

surface clay	0	18
blue clay	18	200
hard	200	385
blue clay	385	400
sand	400	430
both	430	

WELL LOCATION:

sec. 25 T. 15 N. R. 6 E  
 (S) (E)  
 miles SW of Merden  
 (distance) (direction) (nearest town)

WELL PURPOSE: private well  
 (home, irrigation, municipal, industrial)

WELL COMPLETION DATA:

- (1) diameter (inches) 4"
- (2) total depth (feet) 450'
- (3) static water level (feet) 115' below above top of ground
- (4) casing steel 21'  
 (material) (depth)  
4"  
 (size) if telescope see back.
- (5) screen no  
 (length) (depth to top)  
 (size) (material)
- (6) pump no  
 (HP) (yield gpm)  
 (type power)
- (7) electric log no  
 (yes or no)  
 (organization running log)
- (8) how well bottom plugged open

DRILLERS REMARKS:


ALL

RECEIVED

SEP 20 1976

If well telescopes please sketch and show depths.

GROUND LEVEL

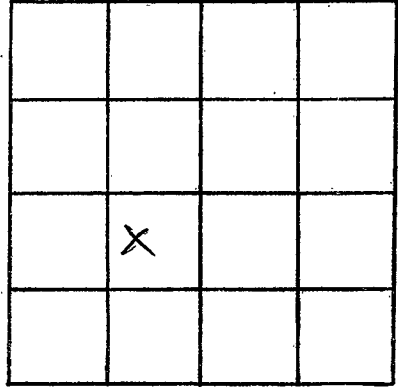

SECTION 28

Please indicate well location X.

ADDITIONAL INFORMATION

If more than one screen,  
show locations of each on sketch.