

MONROE
 # 2036
 9-17-76

MISSISSIPPI
 BOARD OF WATER COMMISSIONERS
 416 North State Street
 Jackson, Mississippi 39201

WATER WELL DRILLERS LOG

Herman Homan Well & Supply, Inc.
 P. O. Box 42
 SHANNON, MISSISSIPPI 38869

9-17 1976
 date well completed

Monroe
 county well located


LANDOWNER:	description of formations encountered	from	to
Justin & Meads	Surface clay	0	16
JONA LA. (mailing address)	clay sand	16	220
WELL LOCATION: sec 28 T 15 N R 6 E S W 1 1/2 miles NW of Milled (distance) (direction) (nearest town)	clay sand bottom	220	360 400 440 490
WELL PURPOSE: <u>new well</u> (home, irrigation, municipal, industrial)			
WELL COMPLETION DATA:			
(1) diameter (inches) <u>4 1/2</u>			
(2) total depth (feet) <u>440'</u>			
(3) static water level (feet) <u>115'</u> below top of ground.			
(4) casing <u>steel</u> <u>20'</u> (material) (depth)			
<u>4 1/2</u> (size) if telescope see back.			
(5) screen <u>no</u> (length) (depth to top)			
(size) (material)			
(6) pump <u>no</u> (HP) (yield gpm)			
(type power)			
(7) electric log <u>no</u> (yes or no)			
(organization running log)			
(8) how well bottom plugged <u>yes</u>			
DRILLERS REMARKS: <u>see</u>			

RECEIVED

NOV 29 1976

If well telescopes please sketch and show depths.

GROUND LEVEL

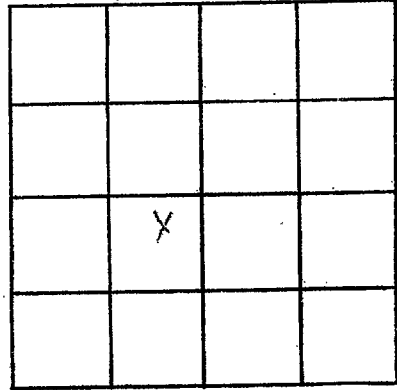

SECTION 28

Please indicate well location X.

ADDITIONAL INFORMATION

If more than one screen, show locations of each on sketch.