

MONROE
 2037
 9-17-76

MISSISSIPPI
 BOARD OF WATER COMMISSIONERS
 416 North State Street
 Jackson, Mississippi 39201

WATER WELL DRILLERS LOG

Herman Homan Well & Supply, Inc.
 P. O. Box 12

SHANNON, MISSISSIPPI 38868

9-17-76
 date well completed

Monroe
 county well located

LANDOWNER:
 Justice & Meads
 JENA LA
 (mailing address)

description of formations encountered	from	to
surface clay	0	16
blue clay	16	220
sand	220	360
clay	360	400
sand	400	420
bottom	420	

WELL LOCATION:
 sec. 27 T 15 N R 6 E
 S W
 1 1/2 miles N W of Muldrow
 (distance) (direction) (nearest town)

WELL PURPOSE: gas well drill
 (home, irrigation, municipal, industrial)

- WELL COMPLETION DATA:
- (1) diameter (inches) 4"
 - (2) total depth (feet) 420'
 - (3) static water level (feet) 118' below top of ground.
 - (4) casing steel 21' (material) (depth)
 4" (size) If telescope see back.
 - (5) screen 20' (length) (depth to top)
 (size) (material)
 - (6) pump 10 HP (HP) (yield gpm)
 (type power)
 - (7) electric log no (yes or no)
 (organization running log)
 - (8) how well bottom plugged o/c


RECEIVED
 NOV 29 1976

DRILLERS REMARKS:
 fill

MISS. BD OF WATER COMMISSIONERS

If well telescopes please sketch and show depths.

GROUND LEVEL

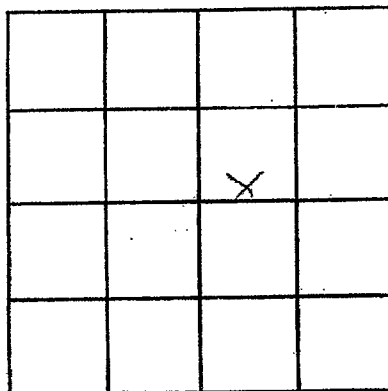

SECTION 27

Please indicate well location X.

ADDITIONAL INFORMATION

If more than one screen,
show locations of each on sketch.