

Monroe
Ø 2038
9-24-76

MISSISSIPPI
 BOARD OF WATER COMMISSIONERS
 416 North State Street
 13E Jackson, Mississippi 39201

WATER WELL DRILLERS LOG

9-29 19 76 Norman Homan Well & Supply, Inc.
 date well completed P.O. Box 42 Monroe
 firm name SHANNON, MISSISSIPPI 38868 county well located

LANDOWNER:

Justiss & Meads
Jena, La.
 (mailing address)

description of formations encountered

from to

Surface clay 0 16
Blue clay 16 220
Sand 220 380
Sand 380 400
Sand 400 440
Bottom 440

WELL LOCATION:

sec. 28 T. 15 N R. 6 E
1 1/2 miles NW of Mudlak
 (distance) (direction) (nearest town)

WELL PURPOSES 500 well pump
 (home, irrigation, municipal, industrial)

WELL COMPLETION DATA:

- (1) diameter (inches) 4"
- (2) total depth (feet) 440'
- (3) static water level (feet) 115' below top of ground.
- (4) casing steel, 21'
 (material) (depth)
49 if telescope see back.
 (size)
- (5) screen ND
 (length) (depth to top)
 (size) (material)
- (6) pump 1/2
 (HP) (yield gpm)
 (type power)
- (7) electric log ND
 (yes or no)
 (organization running log)
- (8) how well bottom plugged OK

RECEIVED


NOV 29 1976

DRILLERS REMARKS:

MISS. BD. OF WATER COMMISSIONERS

If well telescopes please sketch and show depths.

GROUND LEVEL

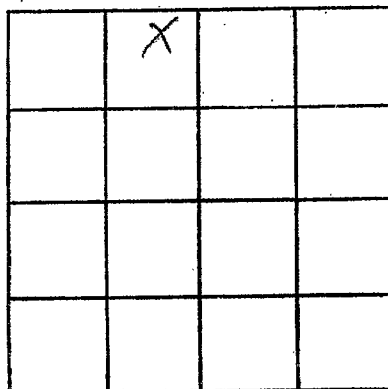

SECTION 28

Please indicate well location X.

ADDITIONAL INFORMATION

If more than one screen,
show locations of each on sketch.