

MONROE
 Ø 2039
 10-15-76

MISSISSIPPI
 BOARD OF WATER COMMISSIONERS
 416 North State Street
 Jackson, Mississippi 39201

WATER WELL DRILLERS LOG

Herman Homan Well & Supply, Inc.

P. O. Box 42

SHANNON, MISSISSIPPI 38868

Monroe county well located

10-15 1976
 date well completed

LANDOWNER:	description of formations encountered	from	to
Justin's Farms	surface clay	0	16
JENA LA (mailing address)	blue clay sand	16	220
WELL LOCATION: sec. 27 T. 25 N. R. 6 E S W	clay sand bottom	220	360
1 1/2 miles NW of Malden (distance) (direction) of (nearest town)		360	400
WELL PURPOSE: as well bottom (home, irrigation, municipal, industrial)		400	440
WELL COMPLETION DATA:			
(1) diameter (inches) 4"			
(2) total depth (feet) 440'			
(3) static water level (feet) 115' below top of ground			
(4) casing steel 21' (material) (depth)			
4" (size) If telescope see back.			
(5) screen ND (length) (depth to top)			
(size) (material)			
(6) pump Na (HP) (yield gpm)			
(type power)			
(7) electric log ND (yes or no)			
(organization running log)			
(8) how well bottom plugged OK			
DRILLERS REMARKS:			


RECEIVED

NOV 29 1976

MISS. BD. OF WATER COMMISSIONERS

If well telescopes please sketch and show depths.

GROUND LEVEL

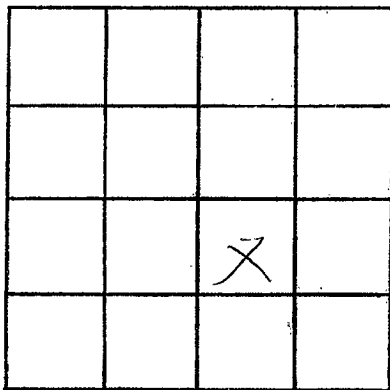

SECTION 27

Please indicate well location X.

ADDITIONAL INFORMATION

If more than one screen, show locations of each on sketch.