

Monroe
Φ 2040
10/18/76

MISSISSIPPI
 BOARD OF WATER COMMISSIONERS
 416 North State Street
 Jackson, Mississippi 39201

WATER WELL DRILLERS LOG

Herman Homan Well & Supply, Inc.
 P. O. Box 12
 firm name

10/18 1976
 date well completed

SHANNON MISSISSIPPI 38468
 county well located

Monroe
 county well located

LANDOWNER:
Fustiss & Meads
LeNA La
 (mailing address)

WELL LOCATION:
 sec. 28 T 15 N R 6 E
1 1/2 miles SW of Muders
 (distance) (direction) (nearest town)

WELL PURPOSE: gas well
 (home, irrigation, municipal, industrial)

- WELL COMPLETION DATA:
- (1) diameter (inches) 4"
 - (2) total depth (feet) 440'
 - (3) static water level (feet) 115' below above top of ground.
 - (4) casing steel 20'
 (material) (depth)
48
 (size) if telescope see back.
 - (5) screen no
 (length) (depth to top)
 (size) (material)
 - (6) pump no
 (HP) (yield gpm)
 (type power)
 - (7) electric log no
 (yes or no)
 (organization running log)
 - (8) how well bottom plugged open

DRILLERS REMARKS:
#22

description of formations encountered	from	to
<u>Surface clay</u>	<u>0</u>	<u>16</u>
<u>blue clay</u>	<u>16</u>	<u>220</u>
<u>sand</u>	<u>220</u>	<u>360</u>
<u>clay</u>	<u>360</u>	<u>400</u>
<u>sand</u>	<u>400</u>	<u>440</u>
<u>Bottom</u>	<u>440</u>	


RECEIVED

NOV 29 1976

MISS. Bd. OF WATER COMM.

If well telescopes please sketch and show depths.

GROUND LEVEL

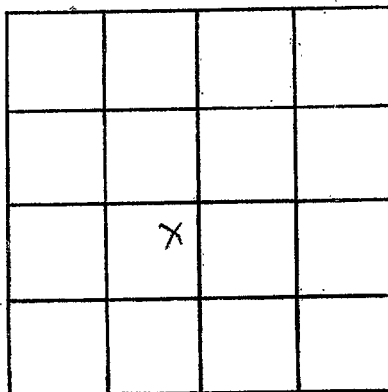

SECTION 28

Please indicate well location X.

ADDITIONAL INFORMATION

If more than one screen,
show locations of each on sketch.