

MONROE
 P 204
 10/28/76

MISSISSIPPI
 BOARD OF WATER COMMISSIONERS
 416 North State Street
 Jackson, Mississippi 39201

WATER WELL DRILLERS LOG

Herman Homan Well & Supply, Inc.

P.O. Box 42

SHANNON, MISSISSIPPI 38868

10/28/76
 date well completed

Monroe
 county well located

LANDOWNER:

Justiss & Moors
 Leake LA.
 (mailing address)

description of formations encountered

from to

surface clay
 blue clay 0 16
 sand 16 310
 clay 310 370
 sand 370 410
 bottom 410

WELL LOCATION:

sec. 29 T. 15 N. R. 6 E. S. W.
 2 miles N 61 W of Moundo
 (distance) (direction) (nearest town)

WELL PURPOSE: GAS WELL DRILLING
 (home, irrigation, municipal, industrial)

WELL COMPLETION DATA:

- (1) diameter (inches) 4 9
- (2) total depth (feet) 410
- (3) static water level (feet) 110 below top of ground.
- (4) casing steel 20' (material) (depth)
 4 9 (size) if telescope see back.
- (5) screen ND (length) (depth to top)
 (size) (material)
- (6) pump ND (HP) (yield gpm)
 (type power)
- (7) electric log ND (yes or no)
 (organization running log)
- (8) how well bottom plugged open

RECEIVED
 NOV 29 1976


DRILLERS REMARKS:

#9

MISS. BD. OF WATER COMMISSIONERS

If well telescopes please sketch and show depths.

GROUND LEVEL

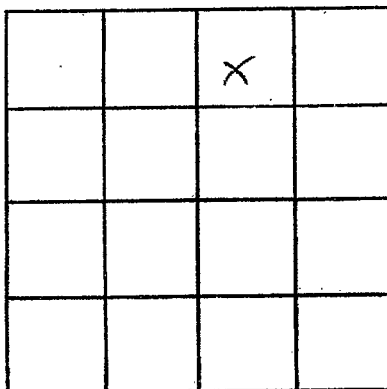

SECTION 28

Please indicate well location X.

ADDITIONAL INFORMATION

If more than one screen, show locations of each on sketch.