

Morroe  
φ 2042  
11-1-76

MISSISSIPPI  
 BOARD OF WATER COMMISSIONERS  
 416 North State Street  
 Jackson, Mississippi 39201

WATER WELL DRILLERS LOG

11-1 date well completed 1976 Herman Homan Well & Supply, Inc. firm name  
 SHANNON MISSISSIPPI 38868 county well located Morroe

LANDOWNER:  
Justiss & Meads  
Texas LA  
 (mailing address)

WELL LOCATION:  
 sec. 28 T. 15 N. R. 6 E.  
1 1/2 miles NE of Maddox  
 (distance) (direction) (nearest town)

WELL PURPOSE: as well drill  
 (home, irrigation, municipal, industrial)

- WELL COMPLETION DATA:
- (1) diameter (inches) 4"
  - (2) total depth (feet) 440'
  - (3) static water level (feet) 115' below above top of ground.
  - (4) casing steel, 21'  
 (material) (depth)  
44 if telescope see back.  
 (size)
  - (5) screen 150 (length) (depth to top)  
 (size) (material)
  - (6) pump 10 (HP) (yield gpm)  
 (type power)
  - (7) electric log no (yes or no)  
 (organization running log)
  - (8) how well bottom plugged open

| description of formations encountered | depth |     |
|---------------------------------------|-------|-----|
|                                       | from  | to  |
| surface sand                          | 0     | 18  |
| clay                                  | 18    | 220 |
| 13' blue clay                         | 220   | 360 |
| sand                                  | 360   | 400 |
| clay                                  | 400   | 440 |
| sand                                  | 440   | 440 |
| Bitton                                |       |     |

**RECEIVED**


NOV 29 1976

DRILLERS REMARKS:  
#22

MISS. BD OF WATER COMM

If well telescopes please sketch and show depths.

GROUND LEVEL

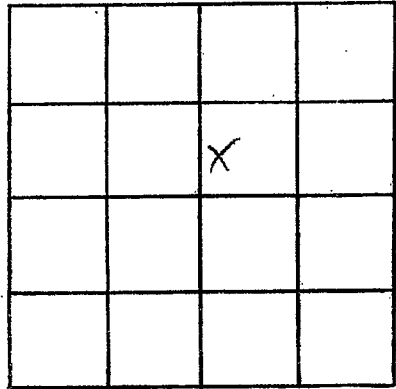

SECTION 28

Please indicate well location X.

ADDITIONAL INFORMATION

If more than one screen,  
show locations of each on sketch.