

Monroe  
Ø 2043  
11/8/76

MISSISSIPPI  
 BOARD OF WATER COMMISSIONERS  
 416 North State Street  
 Jackson, Mississippi 39201

134

WATER WELL DRILLERS LOG

11/8 1976 Herman Homan Well & Supply, Inc. Monroe  
 (date well completed) (firm name) (county well located)

Box 42  
 SHANNON, MISSISSIPPI 38868

LANDOWNER:	description of formations encountered	from	to
<u>Justiss &amp; Meads</u>	<u>surface sand</u>		
<u>JEAN, N.A.</u> (mailing address)	<u>clay</u> <u>Blue clay</u>	<u>0</u>	<u>18</u>
<b>WELL LOCATION:</b> sec. <u>27</u> T. <u>15</u> N. R. <u>6</u> E. S. W. <u>1 1/2</u> miles <u>NW</u> of <u>Muldoon</u> (distance) (direction) (nearest town)	<u>sand</u> <u>Bottom</u>	<u>240</u> <u>440</u>	<u>440</u> <u>740</u>
<b>WELL PURPOSE:</b> <u>gas well water</u> (home, irrigation, municipal, industrial)			
<b>WELL COMPLETION DATA:</b> (1) diameter (inches) <u>Ø 11</u> (2) total depth (feet) <u>440'</u> (3) static water level (feet) <u>115</u> below above top of ground. (4) casing <u>steel</u> (material) (depth) (size) if telescope see back. (5) screen <u>20</u> (length) (depth to top) (size) (material) (6) pump <u>N3</u> (HP) (yield gpm) (type power) (7) electric log <u>no</u> (yes or no) (organization running log) (8) how well bottom plugged <u>open</u>			
<b>DRILLERS REMARKS:</b> <u>KCK</u>			


**RECEIVED**

NOV 29 1976

MISS. BD. OF WATER COMMISSIONERS

If well telescopes please sketch and show depths.

GROUND LEVEL

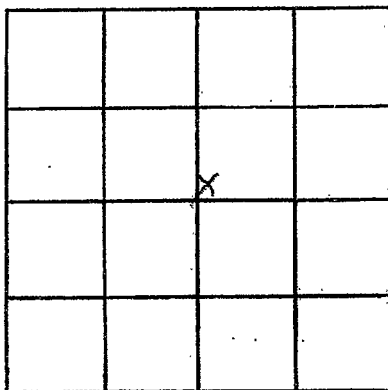

SECTION 27

Please indicate well location X.

ADDITIONAL INFORMATION

If more than one screen,  
show locations of each on sketch.