

Monroe  
Φ 2044  
11/23/76

MISSISSIPPI  
 BOARD OF WATER COMMISSIONERS  
 416 North State Street  
 Jackson, Mississippi 39201

WATER WELL DRILLERS LOG

Warman Homan Well & Supply, Inc.

Monroe  
 county well located

11/23 19 76  
 date/well completed

firm name  
 SHANNON, MISSISSIPPI 39368

LANDOWNER:

Justiss & Meads  
Jena La  
 (mailing address)

description of formations encountered

from to

<u>Surface Clay</u>	<u>0</u>	<u>16</u>
<u>Blue Clay</u>	<u>16</u>	<u>210</u>
<u>Sand</u>	<u>210</u>	<u>360</u>
<u>Clay</u>	<u>360</u>	<u>400</u>
<u>Sand</u>	<u>400</u>	<u>440</u>
<u>Bottom</u>	<u>440</u>	

WELL LOCATION:

sec. 28 T. 15 N. R. 6 E. S. W  
1 1/2 miles NE of Mudlak  
 (distance) (direction) (nearest town)

WELL PURPOSE: as well water  
 (home, irrigation, municipal, industrial)

WELL COMPLETION DATA:

- (1) diameter (inches) 4 1/2
- (2) total depth (feet) 440
- (3) static water level (feet) 115 below top of ground.
- (4) casing Steel, 21' (material) (depth).  
4 1/2 (size) if telescope see back.
- (5) screen NO (length) (depth to top)  
 (size) (material)
- (6) pump AB (HP) (yield gpm)  
 (type power)
- (7) electric log NO (yes or no)  
 (organization running log)
- (8) how well bottom plugged open

**RECEIVED**

DEC 28 1976


DRILLERS REMARKS:

AB

MISS. BD. OF WATER COMMISSIONERS

If well telescopes please sketch and show depths.

GROUND LEVEL

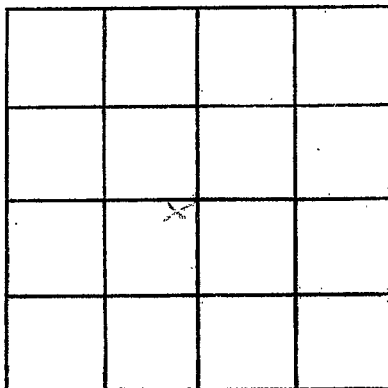

SECTION 28

Please indicate well location X.

ADDITIONAL INFORMATION

If more than one screen, show locations of each on sketch.