

Monroe
Ø 2045
11/24/76

MISSISSIPPI
 BOARD OF WATER COMMISSIONERS
 416 North State Street
 Jackson, Mississippi 39201

WATER WELL DRILLERS LOG

date well completed 11/24 1976 firm name Norman Homan Well & Supply, Inc. county well located Monroe
MISSISSIPPI 38968

LANDOWNER:
Justiss & Meads
Leak LA
 (mailing address)

WELL LOCATION:
 sec. 22 T. 15 N. R. 6 E. S. W
2 miles NE of Malden
 (distance) (direction) (nearest town)

WELL PURPOSE: new well
 (home, irrigation, municipal, industrial)

- WELL COMPLETION DATA:
- (1) diameter (inches) 4"
 - (2) total depth (feet) 440'
 - (3) static water level (feet) 115' below above top of ground.
 - (4) casing steel 21'
 (material) (depth)
4"
 (size) if telescope see back.
 - (5) screen ND
 (length) (depth to top)
 (size) (material)
 - (6) pump ND
 (HP) (yield gpm)
 (type power)
 - (7) electric log ND
 (yes or no)
 (organization running log)
 - (8) how well bottom plugged open

DRILLERS REMARKS: #9

description of formations encountered	from	to
surface clay	0	16
Blue clay	16	200
sand	200	380
clay	380	440
sand	440	460
Bottom	460	


RECEIVED

DEC 28 1976

MISS. BD. OF WATER COMMISSIONERS

If well telescopes please sketch and show depths.

GROUND LEVEL

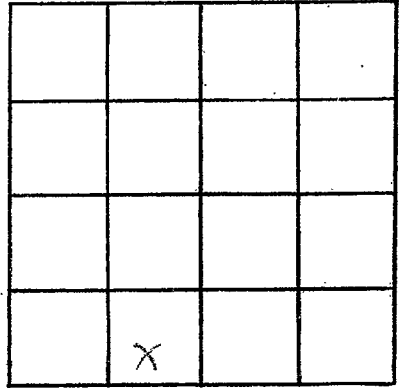

SECTION 22

Please indicate well location X.

ADDITIONAL INFORMATION

If more than one screen,
show locations of each on sketch.