

MONROE
 2046
 11/30/76

MISSISSIPPI
 BOARD OF WATER COMMISSIONERS
 416 North State Street
 Jackson, Mississippi 39201

WATER WELL DRILLERS LOG

11/30 1976 Herman Homan Well & Supply, Inc. Monroe
 date well completed 13E firm name Mississippi 39201 county well located

LANDOWNER:
 Justice & Meade
 Lena Kai
 (mailing address)

WELL LOCATION:
 sec. 27 T. 15 N. R. 6 E
 S W
 1 1/2 miles NW of Mendenhall
 (distance) (direction) (nearest town)

WELL PURPOSE: drinking water
 (home, irrigation, municipal, industrial)

- WELL COMPLETION DATA:
- (1) diameter (inches) 4 1/2
 - (2) total depth (feet) 440
 - (3) static water level (feet) 115 below/above top of ground.
 - (4) casing Steel 21' (material) (depth)
4 (size) if telescope see back.
 - (5) screen NO (length) (depth to top)
 (size) (material)
 - (6) pump NO (HP) (yield gpm)
 (type power)
 - (7) electric log NO (yes/or no)
 (organization running log)
 - (8) how well bottom plugged open

description of formations encountered	from	to
surface clay	0	56
blue clay	56	220
sand	220	360
clay	360	440
sand	440	440
Bottom	440	440

RECEIVED


DEC 28 1976

DRILLERS REMARKS: OK

MISS. BD. OF WATER COMM.

If well telescopes please sketch and show depths.

GROUND LEVEL

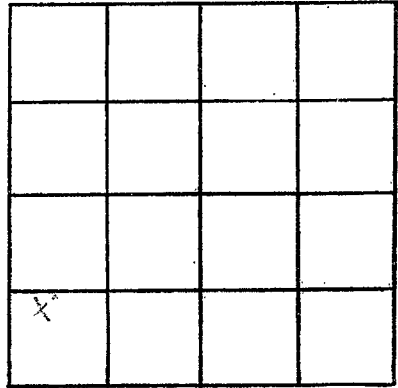

SECTION 27

Please indicate well location X.

ADDITIONAL INFORMATION

If more than one screen, show locations of each on sketch.