

MONROE
 2047
 2-1-77

MISSISSIPPI
 BOARD OF WATER COMMISSIONERS
 416 North State Street
 Jackson, Mississippi 39201

WATER WELL DRILLERS LOG

MONROE

2-1-1977
 date well completed

13L

Herman Homan Well & Supply, Inc.

P.O. Box 42
 firm name

SHANNON, MISSISSIPPI 38668

county well located

LANDOWNER:

Progne Chapel Church

Box 2 West Point, Ms.
 (mailing address)

description of formations encountered

description of formations encountered	from	to
surface soil	0	16
Clay	16	200
Blue clay	200	340
Sand	340	
Bottom		

WELL LOCATION:

sec. 13 T. 16 N. R. 6 E.
 1 1/2 miles SW of Siding
 (distance) (direction) (nearest town)

WELL PURPOSE:

Church
 (home, irrigation, municipal, industrial)

WELL COMPLETION DATA:

- diameter (inches) 4"
- total depth (feet) 340'
- static water level (feet) 150' below top of ground
- casing (material) Steel, (depth) 20' 10"
- screen (length) 4' (depth to top) 20'
- pump (HP) 1/2 (yield gpm) 5
 (type power) electric
- electric log (yes or no) no
- how well bottom plugged open


DRILLERS REMARKS:

RECEIVED
 FEB 22 1977

MISS. BD. OF WATER COMMISSIONERS

If well telescopes please sketch and show depths.

GROUND LEVEL

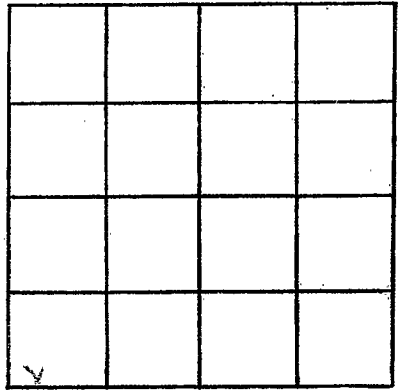

SECTION 13

Please indicate well location X.

ADDITIONAL INFORMATION

If more than one screen,
show locations of each on sketch.