

Monroe
 2049
 11/28/77

MISSISSIPPI
 BOARD OF WATER COMMISSIONERS
 416 North State Street
 Jackson, Mississippi 39201

WATER WELL DRILLERS LOG

11-28 19 77 Herman Homan Well & Supply, Inc.
 date well completed firm name

Monroe county well located

SHANNON, MISSISSIPPI 39209

LANDOWNER:	description of formations encountered	from	to
Clifford Wise RT 1 Prairie, Ms. (mailing address)	Surface sand		0 38
WELL LOCATION: sec. 33 15 T. N. R. 6 E 1 1/2 miles W of Malden (distance) (direction) (nearest town)	Blue clay Sandstone Bottom (20)	38	280
WELL PURPOSE: (home, irrigation, municipal, industrial)			
WELL COMPLETION DATA:			
(1) diameter (inches) 4"			
(2) total depth (feet) 420'			
(3) static water level (feet) 137' below top of ground.			
(4) casing Steel 4" 28' (material) (depth)			
4" (size) if telescope see back.			
(5) screen 20" (length) (depth to top)			
(size) (material)			
(6) pump 1/2 HP 5 (yield gpm)			
electric (type power)			
(7) electric log 20 (yes or no)			
(organization running log)			
(8) how well bottom plugged open			
DRILLERS REMARKS:			


RECEIVED

DEC 22 1977

MISS. BD. OF WATER COMM

If well telescopes please sketch and show depths.

GROUND LEVEL

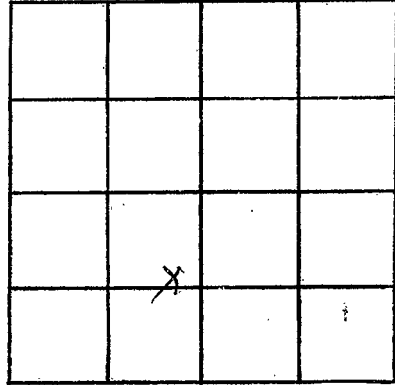

SECTION 33

Please indicate well location X.

ADDITIONAL INFORMATION

If more than one screen,
show locations of each on sketch.