

MONROE

0 2050

S-17-78

MISSISSIPPI
 BOARD OF WATER COMMISSIONERS
 416 North State Street
 Jackson, Mississippi 39201

WATER WELL DRILLERS LOG

Herman Homan Well & Supply, Inc.
 P. O. Box 42
 SHANNON, MISSISSIPPI 38866

MONROE
 county well located

S-17 1978
 date well completed

LANDOWNER:
 EARL SANDERS
 Rt 3 West Point Ms
 (mailing address)

| description of fomations encountered | from | to |
|--------------------------------------|------|-----|
| surface clay | 0 | 30 |
| Blue clay | 30 | 300 |
| Sand | 300 | 490 |
| Bottom | 490 | |

WELL LOCATION:
 sec. 35 T 16 N R 6 E
 1 miles SSW of Muldo
 (distance) (direction) (nearest town)

WELL PURPOSE: PUMP
 (home, irrigation, municipal, industrial)

- WELL COMPLETION DATA:
- (1) diameter (inches) 5"
 - (2) total depth (feet) 490'
 - (3) static water level (feet) 45' below top of ground.
 - (4) casing steel 34 7/8" (material) (depth) 5" If telescope see back.
 - (5) screen ND (length) (depth to top) (size) (material)
 - (6) pump ND (HP) (yield gpm) (type power)
 - (7) electric log ND (yes or no) (organization running log)
 - (8) how well bottom plugged open


RECEIVED
 JUN - 8 1978

DRILLERS REMARKS:

MISS. D. ... OMM

If well telescopes please sketch and show depths.

GROUND LEVEL

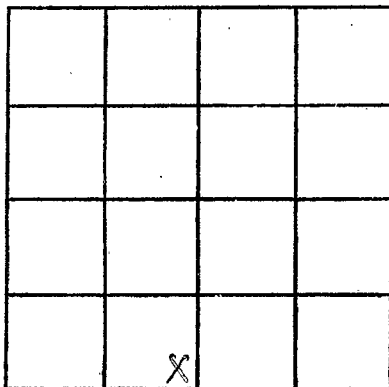

SECTION 33

Please indicate well location X.

ADDITIONAL INFORMATION

If more than one screen,
show locations of each on sketch.