

MONROE

0 2051

MISSISSIPPI
 BOARD OF WATER COMMISSIONERS
 416 North State Street
 Jackson, Mississippi 39201

WATER WELL DRILLERS LOG

MONROE

[Signature]

6/26/78 date well completed

1978 Herman Homan Well & Supply, Inc.

firm name 42 SHANNON MISSISSIPPI 38868

county well located


LANDOWNER:	description of formations encountered	from	to
Royce Davis West Point Ms. (mailing address)	surface sand blue clay sand bottom	0 18 220 360	18 220 360
WELL LOCATION: sec. 17 T. 16 N. R. 6 E. 4 1/2 miles W of ST Joes (distance) (direction) (nearest town)			
WELL PURPOSE: (home, irrigation, municipal, industrial)			
WELL COMPLETION DATA: (1) diameter (inches) 5" (2) total depth (feet) 360' (3) static water level (feet) 105' below top of ground. (4) casing steel, 225' (material) (depth) 9" (size) if telescope see back. (5) screen 20 (length) (depth to top) (size) (material) (6) pump 1/2 (HP) 5 (yield gpm) electric (type power) (7) electric log NO (yes or no) (organization running log) (8) how well bottom plugged open			
DRILLERS REMARKS:			

RECEIVED
 AUG - 9 1978

MISS. BD. OF WATER COMMISSIONERS

If well telescopes please sketch and show depths.

GROUND LEVEL

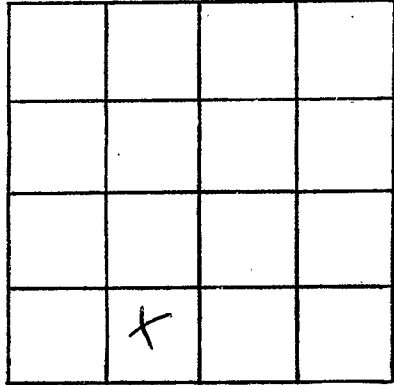

SECTION 17

Please indicate well location X.

ADDITIONAL INFORMATION

If more than one screen, show locations of each on sketch.