

MONROE
 0 2052
 9-25-78

MISSISSIPPI
 BOARD OF WATER COMMISSIONERS
 416 North State Street
 Jackson, Mississippi 39201

WATER WELL DRILLERS LOG

9-25-78 date well completed 1978
 Herman Homan Well & Supply, Inc. firm name
 SHANNON MISSISSIPPI 38868
 Monroe county well located

LANDOWNER:
 L.C. Coose (cont)
 Aberdeen, Ms.
 (mailing address)

description of fomations encountered	from	to
Surface clay	0	18
Blue clay	18	240
Sand	240	360
Bottom	360	

WELL LOCATION:
 sec. 19 T. 15 N. R. 6 E.
 3 miles SW of ~~St. Louis~~
 (distance) (direction) (nearest town)

WELL PURPOSE: Home
 (home, irrigation, municipal, industrial)


- WELL COMPLETION DATA:
- (1) diameter (inches) 5 1/4
 - (2) total depth (feet) 360
 - (3) static water level (feet) 122' below above top of ground.
 - (4) casing steel 21' (material) (depth)
 5 (size) if telescope see back.
 - (5) screen no (length) (depth to top)
 (size) (material)
 - (6) pump 3/4 (HP) 7 (yield gpm)
 electric (type power)
 - (7) electric log no (yes or no)
 - (organization running log)
 - (8) how well bottom plugged open

DRILLERS REMARKS:

RECEIVED
 NOV - 6 1978
 MISS. Bd. OF WATER COMMISSIONERS

If well telescopes please sketch and show depths.

GROUND LEVEL

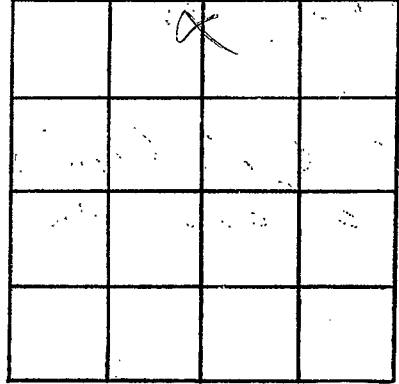

SECTION 18

Please indicate well location X.

ADDITIONAL INFORMATION

If more than one screen, show locations of each on sketch.