

MONROE

02053

10-7-78

MISSISSIPPI BOARD OF WATER COMMISSIONERS 416 North State Street Jackson, Mississippi 39201

WATER WELL DRILLERS LOG

Oct. 7 1978 date well completed

Herman Homan Well & Supply, Inc.

firm name

SHANNON MISSISSIPPI 38668


Madison county well located

LANDOWNER:	description of formations encountered	from	to
<p>Anna Johnson Rt 3 West Cov. M. (mailing address)</p>	<p>surface clay blue clay sand bottom</p>	<p>0 18 19 240 240 350 350</p>	<p>18 240 350 350</p>
<p>WELL LOCATION: sec 29 T 15 N R 6 E S W 2 miles NW of Muldoon (distance) (direction) (nearest town)</p>			
<p>WELL PURPOSE: Home (home, irrigation, municipal, industrial)</p>			
<p>WELL COMPLETION DATA:</p>			
<p>(1) diameter (inches) 5"</p>			
<p>(2) total depth (feet) 380'</p>			
<p>(3) static water level (feet) 131' below top of ground.</p>			
<p>(4) casing steel, 23' 10" (material) (depth) 54 if telescope see back. (size)</p>			
<p>(5) screen 22" (length) (depth to top) (size) (material)</p>			
<p>(6) pump 3/4 HP (material) (yield gpm) chowan (type power)</p>			
<p>(7) electric log no (yes or no)</p>			
<p>(organization running log)</p>			
<p>(8) how well bottom plugged open</p>			
<p>DRILLERS REMARKS:</p>			

RECEIVED
 NOV - 6 1978
 MISS. BD. OF WATER COMMISSIONERS

If well telescopes please sketch and show depths.

GROUND LEVEL

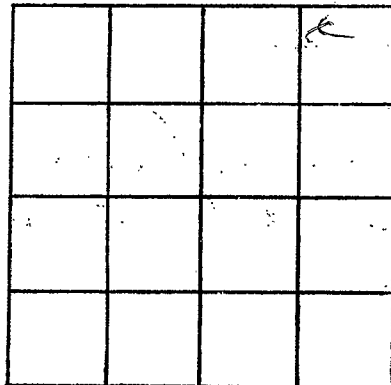

SECTION 29

Please indicate well location X.

ADDITIONAL INFORMATION

If more than one screen, show locations of each on sketch.