

MONROE
 # 2054
 6-1-79

MISSISSIPPI
 BOARD OF WATER COMMISSIONERS
 416 North State Street
 Jackson, Mississippi 39201

WATER WELL DRILLERS LOG

Herman Homan Well & Supply, Inc.
 P. O. Box 42

6-1-79
 date well completed

SHANNON, MISSISSIPPI 38668
 firm name

Monroe
 county well located

LANDOWNER: Contractor

Gregg Construction
West Point, Ms
 (mailing address)

description of formations
 encountered

	from	to
surface clay	0	18
blue clay	18	240
sand	240	380
bottom	380	

WELL LOCATION:

sec 5 T 16 N R 6 E
 S W
2 miles SW of Muldoon
 (distance) (direction) (nearest town)

WELL PURPOSE: Home
 (home, irrigation, municipal, industrial)

WELL COMPLETION DATA:

- diameter (inches) 5"
- total depth (feet) 380'
- static water level (feet) 135 below
 top of ground.
- casing steel 23'9"
 (material) (depth)
5"
 (size) if telescope see back.
- screen ND
 (length) (depth to top)
 (size) (material)
- pump 1/2 5
 (HP) (yield gpm)
check
 (type power)
- electric log no
 (yes or no)
 (organization running log)

(8) how well bottom plugged open

DRILLERS REMARKS:


Miss. Board of Water Comm.

JUL 2 1979

RECEIVED

If well telescopes please sketch and show depths.

GROUND LEVEL

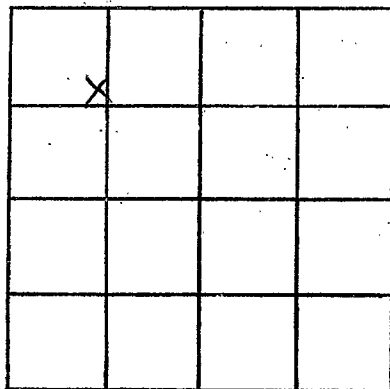

SECTION 5

Please indicate well location X.

ADDITIONAL INFORMATION

If more than one screen, show locations of each on sketch.