

MONROE
 O 2053
 7-6-79

MISSISSIPPI
 BOARD OF WATER COMMISSIONERS
 416 North State Street
 Jackson, Mississippi 39201

WATER WELL DRILLERS LOG

MONROE
 [Signature]

7-6-79 date well completed 19 75 firm name: Herman Homan Well & Supply, Inc. P.O. BOX 42
 SHANNON MISSISSIPPI 38668 county well located

LANDOWNER: Rose Sanderson
West Point MS
 (mailing address)

description of formations encountered	from	to
grit layer sand		
+ clay	0	16
blue clay	16	22
sand	22	36
bitum	36	

WELL LOCATION:
 sec 17 T 16 N R 6 E
4 miles SW of Muldoon
 (distance) (direction) (nearest town)

WELL PURPOSE: water
 (home, irrigation, municipal, industrial)

- WELL COMPLETION DATA:
- (1) diameter (inches) 5"
 - (2) total depth (feet) 360'
 - (3) static water level (feet) 131' below top of ground.
 - (4) casing Steel 21'
 (material) (depth)
5" if telescope see back.
 (size)
 - (5) screen 10'
 (length) (depth to top)
 (size) (material)
 - (6) pump 1/2 5
 (HP) (yield gpm)
electric
 (type power)
 - (7) electric log no
 (yes or no)
 (organization running log)
 - (8) how well bottom plugged open

Miss. Board of Water Comm.


AUG 13 1979

RECEIVED

DRILLERS REMARKS:

If well telescopes please sketch and show depths.

GROUND LEVEL

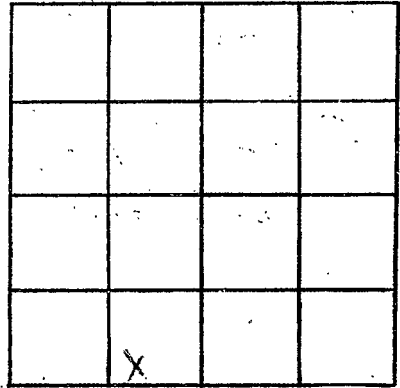

SECTION 17

Please indicate well location X.

ADDITIONAL INFORMATION

If more than one screen,
show locations of each on sketch.