

Monroe  
 2056  
 10-25-79

MISSISSIPPI  
 BOARD OF WATER COMMISSIONERS  
 416 North State Street  
 Jackson, Mississippi 39201

WATER WELL DRILLERS LOG

Herman Homan Well & Supply, Inc.

P. O. Box 42

10-25-1979  
 date well completed

SHANNON, MISSISSIPPI 38658

Monroe  
 county well located

LANDOWNER: (Contractor)  
Fred Morgan  
 Rt 3 West Point, Ms  
 (mailing address)

description of formations encountered	from	to
surface clay	0	25
Blue clay	25	240
sand	240	300
Bottom	300	

WELL LOCATION:  
 sec. 7 T. 16 R. 6E  
2 3/4 miles SW of Malden  
 (distance) (direction) (nearest town)

WELL PURPOSE: Home  
 (home, irrigation, municipal, industrial)

- WELL COMPLETION DATA:
- (1) diameter (inches) 5"
  - (2) total depth (feet) 380'
  - (3) static water level (feet) 126' below above top of ground.
  - (4) casing Steel, 3 1/2"  
 (material), (depth)  
5" If telescope see back.  
 (size)
  - (5) screen 20',  
 (length) (depth to top)  
 (size) (material)
  - (6) pump 1/2 5  
 (HP) (yield gpm)  
electric  
 (type power)
  - (7) electric log no  
 (yes or no)
  - (organization running log)
  - (8) how well bottom plugged open

DRILLERS REMARKS:


DEPT. OF NATURAL RESOURCES  
 BUREAU OF LAND & WATER RESOURCES

DEC - 7 1979

RECEIVED

If well telescopes please sketch and show depths.

GROUND LEVEL

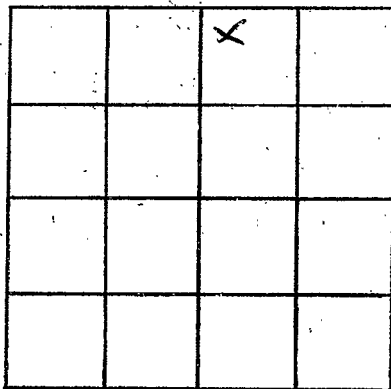

SECTION 7

Please indicate well location X.

ADDITIONAL INFORMATION

A series of horizontal lines for recording additional information.

If more than one screen, show locations of each on sketch.