

Monroe
 Q 2058
 11-4-79

MISSISSIPPI
 BOARD OF WATER COMMISSIONERS
 416 North State Street
 Jackson, Mississippi 39201

WATER WELL DRILLERS LOG

11-4-79 date well completed 1979 Herman Homan Well & Supply, Inc. firm name 42 MONROE county well located
 CHARLETON, MISSISSIPPI 39401

LANDOWNER:
 Third Union Baptist Church
 Rt 1 Prairie Ms
 (mailing address)

description of formations encountered	from	to
surface sand	0	18
clay	18	200
blue clay	18	200
sand	200	380
Bottom	380	

WELL LOCATION:
 sec 31 T-15 N R-6 E
 3 miles W of Mulbow
 (distance) (direction) (nearest town)

WELL PURPOSE: Church
 (home, irrigation, municipal, industrial)

- WELL COMPLETION DATA:
- diameter (inches) 5"
 - total depth (feet) 380'
 - static water level (feet) 26' below top of ground.
 - casing Steel 22' 5" (material) (depth)
 5" If telescope see back. (size)
 - screen rd (length) (depth to top)
 (size) (material)
 - pump 1/2 (HP) 5 (yield gpm)
 electric (type power)
 - electric log no (yes or no)
 - (organization running log)
 - how well bottom plugged open

DRILLERS REMARKS:


MISSISSIPPI DEPT. OF NATURAL RESOURCES
 BUREAU OF LAND & WATER RECORDS

DEC - 7 1979

RECEIVED

If well telescopes please sketch and show depths.

GROUND LEVEL

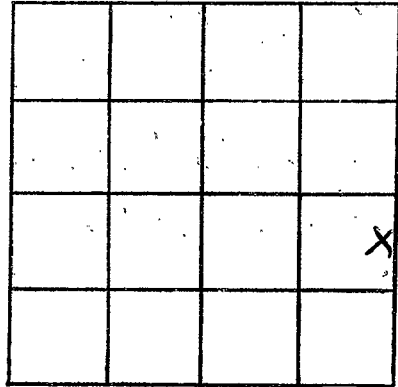

SECTION 31

Please indicate well location X.

ADDITIONAL INFORMATION

Lined area for additional information.

If more than one screen, show locations of each on sketch.