

MISSISSIPPI DEPARTMENT OF NATURAL RESOURCES

Bureau of Land and Water Resources

Southport Mall

P.O. Box 10631

Jackson, Mississippi 39209

WATER WELL DRILLERS LOG

Monroe
0 2060

7-8
 date well completed

1982 Clardy Well Drilling
 firm name

Monroe
 county well located

LANDOWNER: Browning, Walter

description of formations encountered

from

to

P.O. Box, 22680

lime rock

0 8

Jackson, Miss -
 (mailing address) 39205

blue clay

8 91

rock 5"

91

blue clay

91 12.5

rock

123 124

clay

124 242

sandy clay

242 255

sandy streaks

255 264 1/2

rock

264 265 1/2

sandy clay

265 279

sandy streaks

279 295

sandy clay

295 318

hard sandy clay

318 322

sandy clay

322 339

rock

339 341

sandy clay

341 359

sandy streaks

359 361 1/2

clay

361 1/2 368

hard sandy streak

368 375

clay

375 379

sandy streaks

379 384

soft muddy streak

384 410

WELL LOCATION:

sec 32 T 16 N 16 E
14 miles North of West Point
 (distance) (direction) (nearest town)

WELL PURPOSE: ind -
 (home, irrigation, municipal, industrial)

WELL COMPLETION DATA:

(1) diameter (inches) 4"

(2) total depth (feet) 410'

(3) static water level (feet) _____ below above top of ground.

(4) casing PVC 2 1/2" 2 1/2"
 (material) (depth)

_____ if telescope see back.
 (size)

(5) screen _____ (length) _____ (depth to top)

_____ (size) _____ (material)

(6) pump _____ (HP) _____ (yield gpm)

_____ (type power)

(7) electric log _____ (yes or no)

_____ (organization running log)

(8) how well bottom plugged _____

DRILLERS REMARKS:

for gas rig


DEPT. OF NATURAL RESOURCES
 BUREAU OF LAND & WATER RESOURCES

AUG 20 1982

RECEIVED

If well telescopes please sketch and show depths.

GROUND LEVEL

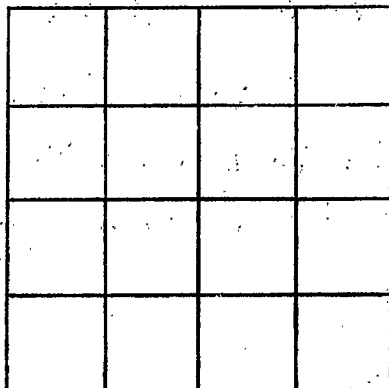

SECTION _____

Please indicate well location X.

ADDITIONAL INFORMATION

If more than one screen,
show locations of each on sketch.