

Monroe
 2061
 10/17/85

MISSISSIPPI
 BOARD OF WATER COMMISSIONERS
 416 North State Street
 Jackson, Mississippi 39201

WATER WELL DRILLERS LOG

Leeper Drilling

Monroe

date well completed

firm name

county well located

LANDOWNER: King's Chapel

Methodist Church

description of formations encountered

from

to

PARADISE MS

(mailing address)

TOP CLAY
 BLUE CLAY
 CHALK
 SAND

0 20
 20 100
 100 220
 220 320

WELL LOCATION:

sec. 32 T15 N R. 6 E
 10 miles SE of ABERDEEN
 (distance) (direction) (nearest town)


WELL PURPOSE: Home
 (home, irrigation, municipal, industrial)

WELL COMPLETION DATA:

- (1) diameter (inches) 4"
- (2) total depth (feet) 320
- (3) static water level (feet) 100 below top of ground
- (4) casing PVC 60 (material), (depth)
 4" (size) if telescope see back.
- (5) screen NONE (length), (depth to top)
- (6) pump 3/4 (HP), 7 (yield gpm)
 Elec (type power)
- (7) electric log NO (yes or no)

(organization running log)

(8) how well bottom plugged OPEN

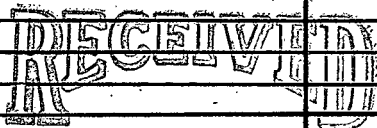


NOV 20 1985

DRILLERS REMARKS:

If well telescopes please sketch and show depths.

GROUND LEVEL

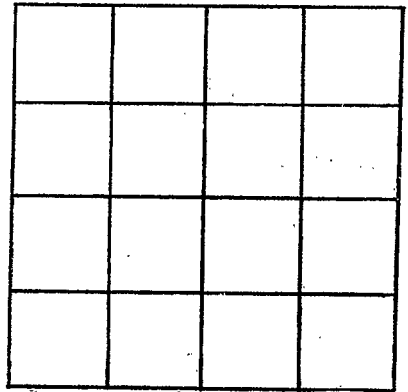

SECTION _____

Please indicate well location X.

ADDITIONAL INFORMATION

If more than one screen, show locations of each on sketch.