

**MONROE**  
**P31**  
**10-20-71**

MISSISSIPPI  
 BOARD OF WATER COMMISSIONERS  
 416 North State Street  
 Jackson, Mississippi 39201

**CODED**

WATER WELL DRILLERS LOG

~~10-20~~ 19 71 Herndon-Homan Well & Supply, Inc. Monroe  
 date well completed firm name county well located  
 BEAUNON, MISSISSIPPI 38868

LANDOWNER: Bobby Staten  
Aberdeen, Miss.  
 (mailing address)

description of formations encountered	from	to
<u>Surface sand &amp; clay</u>	<u>0</u>	<u>95</u>
<u>Other clay</u>	<u>95</u>	<u>160</u>
<u>Sand</u>	<u>160</u>	<u>300</u>
<u>Bottom</u>	<u>300</u>	

WELL LOCATION:  
 sec. 35 T. 15 N. R. 7 E  
S W  
4 1/2 miles S of Aberdeen  
 (distance) (direction) (nearest town)

WELL PURPOSE: home  
 (home, irrigation, municipal, industrial)

- WELL COMPLETION DATA:
- diameter (inches) 4"
  - total depth (feet) 300
  - static water level (feet) 118 below top of ground.
  - casing Steel 10 1/4"  
 (material) (depth)  
4" if telescope see back.  
 (size)
  - screen NO  
 (length) (depth to top)  
 (size) (material)
  - pump 3/4 3  
 (HP) (yield gpm)  
Electric  
 (type power)
  - electric log no  
 (yes or no)  
 (organization running log)
  - how well bottom plugged open

**CODED**


NOV 10 1971

DRILLERS REMARKS:

MISS. BD. OF  
 WATER COMM.

If well telescopes please sketch and show depths.

GROUND LEVEL

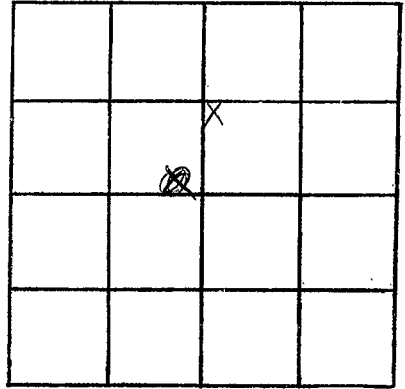

SECTION 35

Please indicate well location X.

ADDITIONAL INFORMATION

If more than one screen,  
show locations of each on sketch.