

Monroe
P33
12-20-69

MISSISSIPPI
BOARD OF WATER COMMISSIONERS
416 North State Street
Jackson, Mississippi 39201

CODED

WATER WELL DRILLERS LOG

Herndon-Homan Well & Supply, Inc. *Monroe*
P. O. Box 42

date well completed 12-20-69 county well located Monroe
ON LEFT ON DATE CUT W. H. GILREATH SHANNON, MISSISSIPPI 38888

LANDOWNER Shirley Williams

description of formations encountered

from to

Route 2 2565490

Surface sand & clay	0	80
Blue clay	80	220
Sand	220	360
Bottom	360	

Annex, Miss.
(mailing address)

WELL LOCATION:

sec. 35 T-15 N R-7 E
S W
5 miles S of Abbeea
(distance) (direction) (nearest town)

WELL PURPOSE: home
(home, irrigation, municipal, industrial)

WELL COMPLETION DATA:

- diameter (inches) 4"
- total depth (feet) 360
- static water level (feet) 196 below ~~above~~ top of ground.
- casing Steel, 186'
(material) (depth)
4" if telescope see back.
(size)
- screen _____
(length) (depth to top)
(size) (material)
- pump 1/2 _____
(HP) (yield gpm)
Electric
(type power)
- electric log no
(yes or no)
- (organization running log)
- how well bottom plugged open

CODED


JAN - 8 1970

MISS. BD. OF
WATER COMM.

DRILLERS REMARKS:

If well telescopes please sketch and show depths.

GROUND LEVEL

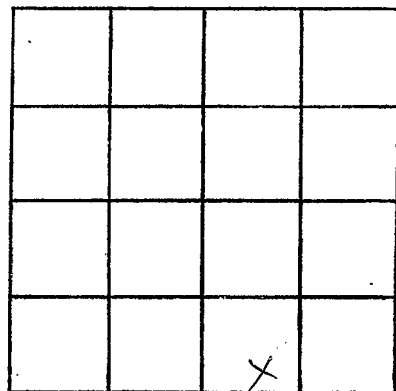

SECTION 35

Please indicate well location X.

ADDITIONAL INFORMATION

If more than one screen,
show locations of each on sketch.