

MONROE
P 34
4-26-72

MISSISSIPPI
 BOARD OF WATER COMMISSIONERS
 416 North State Street
 Jackson, Mississippi 39201

CODED

WATER WELL DRILLERS LOG

Herndon-Homan Well & Supply, Inc.

426 1972 P. O. Box 42 Monroe
 date well completed SEANNON, MISSISSIPPI 38868 county well located

LANDOWNER: David Holiday
Roy Reece
Attn: Aberdeen, Miss
 (mailing address)

description of formations encountered	from	to
<u>Surface clay</u>	<u>0</u>	<u>15</u>
<u>Blue clay</u>	<u>15</u>	<u>140</u>
<u>Sand</u>	<u>140</u>	<u>280</u>
<u>Bottom</u>	<u>280</u>	

WELL LOCATION:
 sec. 29 T 15 N R. 9 E
3/4 miles W of Birford
 (distance) (direction) (nearest town)

WELL PURPOSE: Home
 (home, irrigation, municipal, industrial)

- WELL COMPLETION DATA:
- (1) diameter (inches) 5"
 - (2) total depth (feet) 280"
 - (3) static water level (feet) 70 below top of ground
 - (4) casing steel 18' 3"
 (material) (depth)
5" if telescope see back.
 (size)
 - (5) screen 10 5
 (length) (depth to top)
 (size) (material)
 - (6) pump 1/2 5
 (HP) (yield gpm)
electric
 (type power)
 - (7) electric log no
 (yes or no)
 (organization running log)
 - (8) how well bottom plugged open

CODED

290
70
220


MAY 12 1972

MISS. BD. OF
 WATER COMM.

DRILLERS REMARKS:

If well telescopes please
sketch and show depths.

GROUND LEVEL

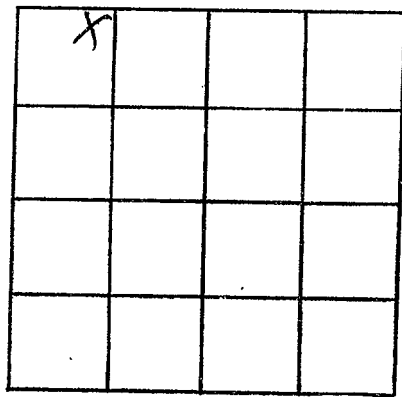

SECTION 29

Please indicate well location X.

ADDITIONAL INFORMATION

If more than one screen,
show locations of each on sketch.