

MONROE
P35
7-24-70

MISSISSIPPI
BOARD OF WATER COMMISSIONERS
416 North State Street
Jackson, Mississippi 39201

CODED

WATER WELL DRILLERS LOG

7-24 1970 W.J. REEVES & SON MONROE
date well completed firm name county well located

LANDOWNER: W.D. OTT

description of formations encountered	from	to
CLAY	0	30
BLUE CLAY	30	155
" SAND	155	160
" CLAY	160	195
" SAND	195	210
" CLAY	210	230
" SAND	230	242
" CLAY	242	290
" SAND	290	330
BLUE CLAY & SAND	330	353

RT. 4

ABERDEEN
(mailing address)

WELL LOCATION:

sec. 7 T. 16 N. R. 7E
①
2 miles So of ABERDEEN
(distance) (direction) (nearest town)

WELL PURPOSE: HOME
(home, irrigation, municipal, industrial)

WELL COMPLETION DATA:

- (1) diameter (inches) 4
- (2) total depth (feet) 353
- (3) static water level (feet) 96 below above top of ground.
- (4) casing STEEL 42 1/2
(material) (depth)
4 If telescope see back.
(size)
- (5) screen NONE
(length) (depth to top)
(size) (material)
- (6) pump 3 30
(HP) (yield gpm)
ELECT
(type power)
- (7) electric log NO
(yes or no)
(organization running log)
- (8) how well bottom plugged OPEN

CODED


AUG 26 1970

MISS. DE. OF
WATER CONTROL

DRILLERS REMARKS:

If well telescopes please sketch and show depths.

GROUND LEVEL

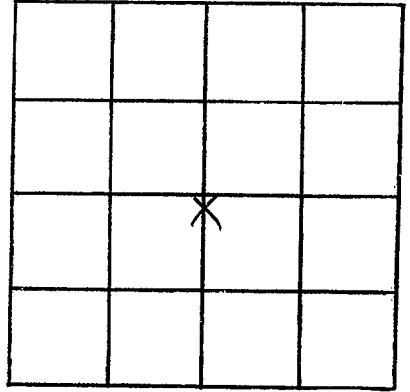

SECTION 7

Please indicate well location X.

ADDITIONAL INFORMATION

If more than one screen,
show locations of each on sketch.