

MISSISSIPPI
BOARD OF WATER COMMISSIONERS
416 North State Street
Jackson, Mississippi 39201

CODED

WATER WELL DRILLERS LOG

MONROE
P 37
1-21-71

date well completed 1-21 19 71 Herndon-Homan Well # Monroe
firm name Wm. BURGESS county well located Suppley

LANDOWNER: Co-operative
Home Builders (Contractor)
Box 510, Aberdeen, Miss 39730
(mailing address)

description of formations encountered	from	to
<u>Surface clay</u>	<u>0</u>	<u>18</u>
<u>Blue clay</u>	<u>18</u>	<u>60</u>
<u>Sand</u>	<u>60</u>	<u>200</u>
<u>Bottom</u>	<u>200</u>	

WELL LOCATION:
sec. 29 T. 15 N. R. 7 E. W. W
1/2 miles W of Winford
(distance) (direction) (nearest town)

WELL PURPOSE: Home
(home, irrigation, municipal, industrial)

- WELL COMPLETION DATA:
- (1) diameter (inches) 5"
 - (2) total depth (feet) 200'
 - (3) static water level (feet) 65 below top of ground.
 - (4) casing Steel, 20'6" (material) (depth)
5" (size) if telescope see back.
 - (5) screen NO (length) (depth to top)
(size) (material)
 - (6) pump 1/3 (HP) 5 (yield gpm)
Electric (type power)
 - (7) electric log NO (yes or no)
(organization running log)
 - (8) how well bottom plugged open

CODED


FEB 23 1971

DRILLERS REMARKS:

MISS. Bd. of
Water Comm.
Form No. 10-67

If well telescopes please sketch and show depths.

GROUND LEVEL

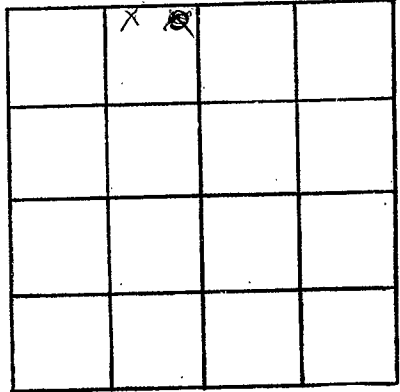

SECTION 29

Please indicate well location X.

ADDITIONAL INFORMATION

If more than one screen,
show locations of each on sketch.