

MONROE
P 38
3-1-71

MISSISSIPPI
 BOARD OF WATER COMMISSIONERS
 416 North State Street
 Jackson, Mississippi 39201

CODED

WATER WELL DRILLERS LOG

Herndon-Homan Well & Supply, Inc. *Monroe*

3-1 date well completed 19 *71* *Monroe* county well located
 F. O. Box 42
 SHANNON, MISSISSIPPI 38868

LANDOWNER: *George Collins*
Route 4
Aberdeen, Miss 39130
 (mailing address)

description of formations encountered	from	to
<i>Surface Sand</i>		
<i>& clay</i>	<i>0</i>	<i>115</i>
<i>Blue clay</i>	<i>115</i>	<i>200</i>
<i>Sand</i>	<i>200</i>	<i>390</i>
<i>Bottom</i>	<i>390</i>	

WELL LOCATION:
 sec. *35 T 15 N* R. *7 E*
5 miles *S* of *Aberdeen*
 (distance) (direction) (nearest town)

WELL PURPOSE: *home*
 (home, irrigation, municipal, industrial)

- WELL COMPLETION DATA:
- (1) diameter (inches) *4"*
 - (2) total depth (feet) *340*
 - (3) static water level (feet) *120* below top of ground. *above*
 - (4) casing *Steel* *108'*
(material) (depth)
4" (size) if telescope see back.
 - (5) screen _____
(length) (depth to top)
(size) (material)
 - (6) pump _____
(HP) (yield gpm)
(type power)
 - (7) electric log *no*
(yes or no)
(organization running log)
 - (8) how well bottom plugged *open*

CODED


APR 12 1971

DRILLERS REMARKS:

MISSISSIPPI BOARD OF WATER COMMISSIONERS
 WATER CONTROL

If well telescopes please sketch and show depths.

GROUND LEVEL

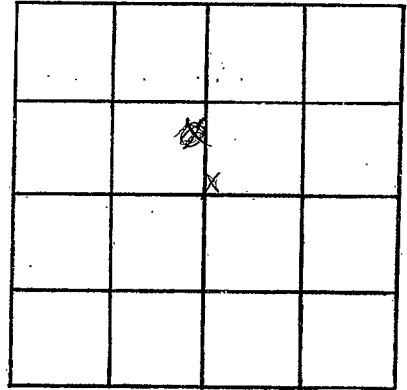

SECTION 35

Please indicate well location X.

ADDITIONAL INFORMATION

If more than one screen,
show locations of each on sketch.