

MONROE
P 39
5-25-71

MISSISSIPPI
BOARD OF WATER COMMISSIONERS
416 North State Street
Jackson, Mississippi 39201

CODED

WATER WELL DRILLERS LOG

Herndon-Homan Well & Supply, Inc. *Merroe*

date well completed 5-25 1971 SHANNON MISSISSIPPI DESSA county well located

LANDOWNER: Wilford H. Darnell
3694767

description of formations encountered	from	to
<u>Simon sand & clay</u>	<u>0</u>	<u>98'</u>
<u>Other clay</u>	<u>98'</u>	<u>120'</u>
<u>Sand</u>	<u>120'</u>	<u>260'</u>
<u>Bottom</u>	<u>260'</u>	

207 W. Monroe St.
Aberdeen, Miss 39730
(mailing address)

WELL LOCATION:

23rd T 15 N R 7 E
4 miles S of Aberdeen
(distance) (direction) (nearest town)

WELL PURPOSE: home
(home, irrigation, municipal, industrial)

WELL COMPLETION DATA:

- (1) diameter (inches) 5"
- (2) total depth (feet) 260'
- (3) static water level (feet) 143 below top of ground.
- (4) casing Steel 104'6"
(material) (depth)
- 5"
(size) if telescope see back.
- (5) screen no
(length) (depth to top)
- (size) (material)
- (6) pump 1/2 5
(HP) (yield gpm)
- electric
(type power)
- (7) electric log no
(yes or no)

CODED

(organization running log)

(8) how well bottom plugged open


JUN 15 1971

DRILLERS REMARKS:

MISS. BD. OF
WATER COMM.

If well telescopes please sketch and show depths.

GROUND LEVEL

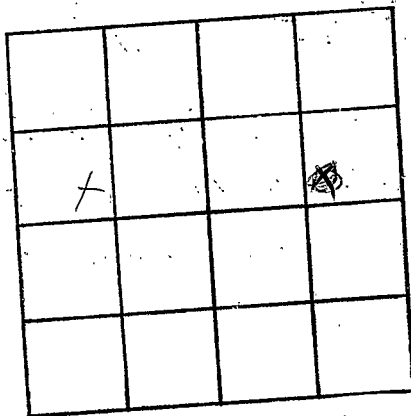

SECTION 23
~~26~~

Please indicate well location X.

ADDITIONAL INFORMATION

If more than one screen, show locations of each on sketch.