

Monroe
P 40
4-67

MISSISSIPPI
BOARD OF WATER COMMISSIONERS
416 North State Street
Jackson, Mississippi 39201

CODED

WATER WELL DRILLERS LOG
Herndon-Homan Well & Supply, Inc.

P. O. Box 42

SHANNON, MISSISSIPPI 38868

Monroe
county well located

4-22 1967
date well completed

LANDOWNER:

Edd Brazzell
at Aberdeen, Miss
(mailing address)

description of formations
encountered

from to

Bayou sand & clay	0	35
Blue clay	35	150
sand	150	300
Bottom	300	

WELL LOCATION:


109 T 15 N R 7 E
sec 9 S 4 W
3 miles SW of Aberdeen
(distance) (direction) (nearest town)

WELL PURPOSE: Home
(home, irrigation, municipal, industrial)

WELL COMPLETION DATA:

- (1) diameter (inches) 5"
- (2) total depth (feet) 300'
- (3) static water level (feet) 80 below above top of ground.
- (4) casing steel, 38'
(material) (depth)
5"
(size) if telescope see back.
- (5) screen none
(length) (depth to top)
(size) (material)
- (6) pump 3/4 200
(HP) (yield gpm)
electric
(type power)
- (7) electric log no
(yes or no)
(organization running log)
- (8) how well bottom plugged open

CODED

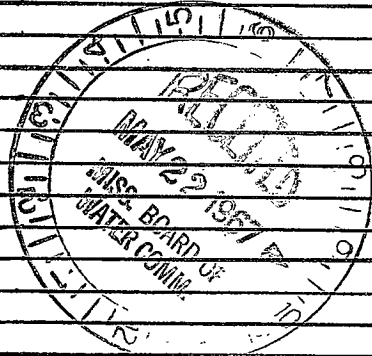

DRILLERS REMARKS:

