

MONROE

MISSISSIPPI BOARD OF WATER COMMISSIONERS

P41

WATER WELL DRILLERS LOG

CODED

9-5-62

HERNDON WELL & SUPPLY CO.

Date: Sept 5, 1962, Driller: SHANNON, P. O. BOX 42, County Monroe

SHANNON, MISSISSIPPI

H. W.

(1) Owner of Land:	Description & Color of Materials Sand, Clay, Red Clay, Shell, etc.	Thick- ness Feet	Depth Feet
(Name) <u>H. Dold</u> (Address) <u>Aberdeen, Miss</u>	<u>Clay</u>		<u>0</u>
(2) Location <u>30 1/4, NENE 1/4, Sec. 29 T 155 R 7E</u> <u>5</u> miles <u>SW</u> of <u>Aberdeen</u> (distance) (direction) (Nearest Town)	<u>Blue rock</u>		<u>45</u>
(3) Topography: <u>FLAT</u> (Hilly) (Flat) (Level)	<u>Sand</u>		<u>105</u>
(4) Purpose of Well: <u>Domestic</u> (Domestic Irrigation Municipal, Industrial, Other)	<u>Blue rock</u>		<u>185</u>
	<u>Sand</u>		<u>360</u>
	<u>Bottom</u>		<u>480</u>

Information upon completion of well:


- (1) Diameter 4 inches.
- (2) Total Depth 480 feet.
- (3) Water Level 80 feet below top of ground.
- (4) Cased to 222 ft, Size 4"
- (5) Screen: Size , Length
- (6) Were any formations sealed against pollution?
 yes, no.

If YES depth of formation 175'

Why surface of sand

Drillers Remarks:

CODED

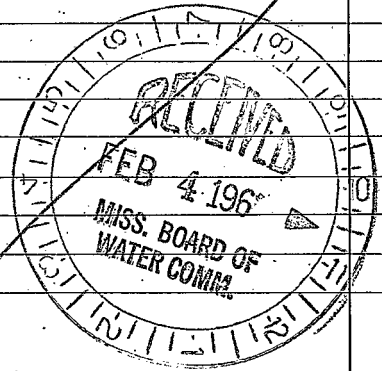

(Use Back Side)

Well No.

