

MONROE
P 43
12-67

MISSISSIPPI
BOARD OF WATER COMMISSIONERS
416 North State Street
Jackson, Mississippi 39201

CODED

WATER WELL DRILLERS LOG

12/20 1967 Herndon-Homan Well & Supply, Inc. P. O. Box 42 MONROE
date well completed firm name SHANNON, MISSISSIPPI 38868 county well located

LANDOWNER: J.C. OTT
~~George McGhee~~
RT Aberdeen, Miss.
(mailing address)

description of formations encountered	from	to
surface sand & clay	0	70
blue clay	70	180
swamp	180	300
Bottom	300	

WELL LOCATION:
Sec. 4 T. 16 N. R. 7 E.
S. W. 6 miles S of Aberdeen
(distance) (direction) (nearest town)


WELL PURPOSE: Home
(home, irrigation, municipal, industrial)

WELL COMPLETION DATA:

- (1) diameter (inches) 5
- (2) total depth (feet) 300
- (3) static water level (feet) 58 below top of ground.
- (4) casing steel 7.5 5' (material) (depth)
(size) If telescope see back.
- (5) screen none (length) (depth to top)
(size) (material)
- (6) pump 1/2 5 (HP) (yield gpm)
electric (type power)
- (7) electric log no (yes or no)
(organization running log)
- (8) how well bottom plugged open

CODED

DRILLERS REMARKS:

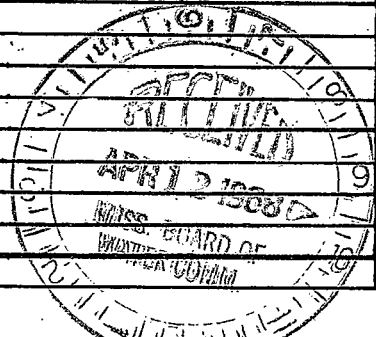

If well telescopes please sketch and show depths.

GROUND LEVEL

			X

SECTION 4

Please indicate well location X.

ADDITIONAL INFORMATION

If more than one screen,
show locations of each on sketch.