

Monroe
 P 45
 7-68

MISSISSIPPI
 BOARD OF WATER COMMISSIONERS
 416 North State Street
 Jackson, Mississippi 39201

CODED

WATER WELL DRILLERS LOG
 Shannon-Korman Well & Supply, Inc.

P. O. Box 42
 SHANNON, MISSISSIPPI 39201
 firm name

Monroe
 county well located

7-5 1968
 date well completed

LANDOWNER:
 Bradley Lumber Co.
 Aberdeen Miss
 (mailing address)


description of formations encountered	from	to
Surface Sand	0	60
& clay	60	140
Blue clay	140	260
Sand	260	
Bottom		

WELL LOCATION:
 sec. 11 T. 16 N. R. 7 E.
 8 S. #
 8 miles S of Aberdeen
 (distance) (direction) (nearest town)

WELL PURPOSE: Cabin
 (home, irrigation, municipal, industrial)

- WELL COMPLETION DATA:
- (1) diameter (inches) 4"
 - (2) total depth (feet) 260'
 - (3) static water level (feet) 103' below top of ground.
 - (4) casing Steel 65' 3" (material) (depth)
 4" (size) if telescope see back.
 - (5) screen No (length) (depth to top)
 (size) (material)
 - (6) pump 3/4 HP 5 (type power) (yield gpm)
 - (7) electric log No (yes or no)
 (organization running log)
 - (8) how well bottom plugged open

CODED

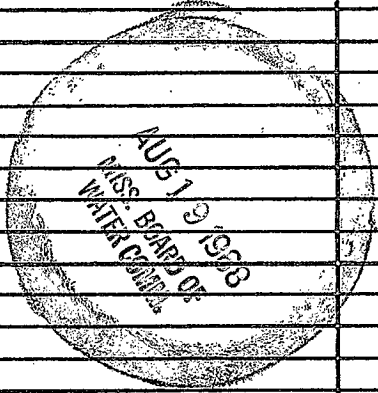

DRILLERS REMARKS:

If well telescopes please sketch and show depths.

GROUND LEVEL

			X

SECTION SK

Please indicate well location X.

ADDITIONAL INFORMATION

If more than one screen, show locations of each on sketch.