

MONROE

P 47

4-68

MISSISSIPPI
 BOARD OF WATER COMMISSIONERS
 416 North State Street
 Jackson, Mississippi 39201

CODED

WATER WELL DRILLERS LOG

4-6 1968 Horndon-Homan Well & Supply, Monroe
 date well completed firm name Box 42 county well located
 STANNON, MISSISSIPPI 38888

LANDOWNER:
Jackie Marchett
At Aberdeen, Miss
 (mailing address)

description of formations encountered	from	to
<u>surface sand</u>		
<u>& clay</u>	<u>0</u>	<u>85</u>
<u>blue clay</u>	<u>85</u>	<u>140</u>
<u>sand</u>	<u>140</u>	<u>260</u>
<u>Bst</u>	<u>260</u>	

WELL LOCATION:
 sec. 11 T 15 N R 2 E
2 1/2 miles S of Aberdeen
 (distance) (direction) (nearest town)

WELL PURPOSE: Home
 (home, irrigation, municipal, industrial)

WELL COMPLETION DATA:


- (1) diameter (inches) 4
- (2) total depth (feet) 260
- (3) static water level (feet) 30 below above top of ground.
- (4) casing Steel, 87'
 (material) (depth)
 _____ If telescope see back.
 (size)
- (5) screen NONE
 (length) (depth to top)

 (size) (material)
- (6) pump 6.5 hp
 (HP) (yield gpm)

 (type power)
- (7) electric log NO
 (yes or no)

 (organization running log)
- (8) how well bottom plugged open


CODED

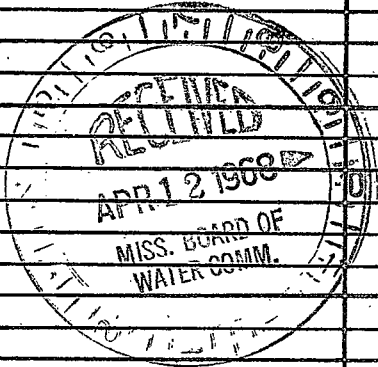

DRILLERS REMARKS:

If well telescopes please sketch and show depths.

GROUND LEVEL

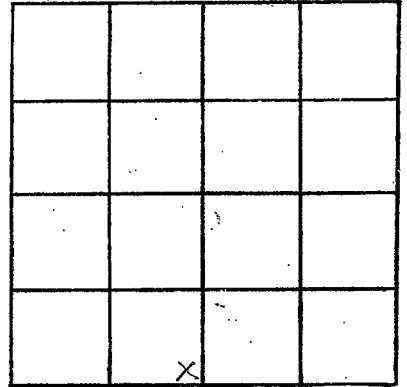

SECTION 11

Please indicate well location X.

ADDITIONAL INFORMATION

If more than one screen,
show locations of each on sketch.