

MONROE  
P 50

WATER WELL DRILLERS LOG

Herndon Well & Drilling Co.

SHANNON, MISSISSIPPI

**CODED**

P 300

Date: Aug 31, 1960, Driller: \_\_\_\_\_

County: Monroe

8-31-60 DARCUT RD - TAKE 1ST RT PAST BRIDGE CORNER HOUSE

(1) Owner of Land: Fred Bell  
(Name)  
Hamilton, Miss.  
(Address)

(2) Location: SE 1/4, SW 1/4, Sec. 16, T15R7  
2 1/2 miles South of Aberdeen  
(distance) (direction) (Nearest Town)

(3) Topography: Level  
(Hilly) (Flat) (Level)

(4) Purpose of Well: Farm Use  
(Domestic Irrigation  
Municipal, Industrial, Other)

Description & Color of Materials Sand, Clay, Red Clay, Shell, etc.	Thick- ness Feet	Depth Feet
<u>SAND AND ROCK</u>		<u>200</u>
<u>Gravel</u>		<u>240</u>
<u>SAND AND ROCK</u>		
<u>Bottom</u>		<u>386</u>

Information upon completion of well:

(1) Diameter 2 inches.

(2) Total Depth 386 feet.

(3) Water Level Flowing feet below top of ground.

(4) Cased to 214', Size 4"  
384'6" 2"


(5) Screen: Size \_\_\_\_\_ Length \_\_\_\_\_

(6) Were any formations sealed against pollution?  
X yes, \_\_\_\_\_ no.

If YES depth of formation 20 ft.  
Why Good & Surface

Drillers Remarks: \_\_\_\_\_

**CODED**

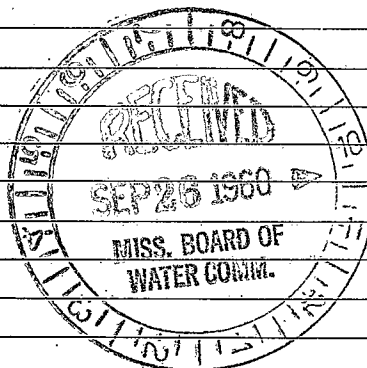

(Use Back Side)

Well No.  
P 300

