

MONROE

MISSISSIPPI BOARD OF WATER COMMISSIONERS

P 51

3-22-62

WATER WELL DRILLERS LOG **CODED**

HERNDON WELL & SUPPLY CO.

Date March 22, 1962 Driller: SHANNON P. O. BOX 42 County Monroe  
Name MISSISSIPPI


(1) Owner of Land: <u>Connie McCordless</u> (Name)	Description & Color of Materials Sand, Clay, Red Clay, Shell, etc.	Thick- ness Feet	Depth Feet
3696306 <u>Abbeville, Miss</u> (Address)	<u>surface soil</u>		<u>0</u>
(2) Location: <u>NW 1/4, NE NW 1/4, Sec 2 T 15 N R 7 E</u> <u>1/2</u> miles <u>South</u> of <u>Abbeville</u> (distance) (direction) (Nearest Town)	<u>clay</u>		<u>59</u>
(3) Topography: <u>Flat</u> (Hilly) (Flat) (Level)	<u>blue rock</u>		
(4) Purpose of Well: <u>Domestic</u> (Domestic Irrigation Municipal, Industrial, Other)	<u>hard</u>	<u>240</u>	
	<u>to</u>		
	<u>bottom</u>	<u>360</u>	

Information upon completion of well:

- (1) Diameter 4 inches.
- (2) Total Depth 360 feet.
- (3) Water Level 90 feet below top of ground.
- (4) Cased to 92', Size 4"
- (5) Screen: Size —, Length —
- (6) Were any formations sealed against pollution?  
yes, no.

**CODED**

If YES depth of formation 59 ft  
Why Harder & sand  
Drillers Remarks:

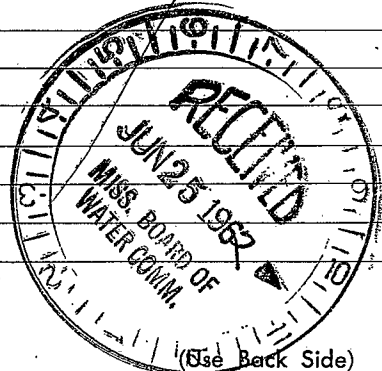

Well No.

